

DP52

7-26-61

WATER WELL DRILLERS LOG

CODED

Date: 7-26, 1961, Driller: J.C. REEVES County MONROE

25 S. TAKE RT at waller Plant 1/2 m + (Name BEAR RT GO UP HILL GO DOWN TURN LEFT RFD DRIVEWAY)

369 4293

(1) Owner of Land: SAM KLINE
Prime Rd. (Name)
ABERDEEN MISS
(Address)

(2) Location: SE 1/4, N 1/4, Sec. 8 T/5R 7,

3 miles WEST of ABERDEEN
(distance) (direction) (Nearest Town)

(3) Topography: HILLY
(Hilly) (Flat) (Level)

(4) Purpose of Well: DOM.
(Domestic Irrigation
Municipal, Industrial, Other)

Description & Color of Materials
Sand, Clay, Red Clay, Shell; etc.

Thick-
ness:
Feet

Depth
Feet

CLAY 32 0

BLUE CLAY 15 32

" SAND 16 189

" CLAY 11 205

" SAND 14 216

" CLAY 38 230

" SAND 39 268

Information upon completion of well:

(1) Diameter 4 inches.

(2) Total Depth 307 feet.

(3) Water Level 98' feet below top of ground.

(4) Cased to 42 1/2', Size 4"

(5) Screen: Size _____, Length _____

(6) Were any formations sealed against pollution?


_____ yes, _____ no.

If YES depth of formation _____

Why _____

Drillers Remarks: _____

CODED

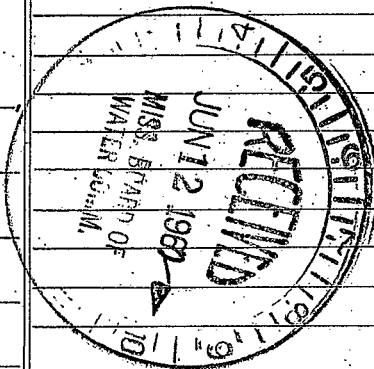

(Use Back Side)

Well

[The page contains extremely faint and illegible text, likely bleed-through from the reverse side of the document. The text is scattered across the page and does not form any recognizable words or sentences.]