

MISSISSIPPI  
 BOARD OF WATER COMMISSIONERS  
 416 North State Street  
 Jackson, Mississippi 39201

**CODED**

**MONROE**  
~~53~~  
**4-3-72**

**WATER WELL DRILLERS LOG**

April 3 1972 Herndon Well & Supply Co. Monroe  
 date well completed firm name county well located

| LANDOWNER:   | description of formations encountered | from | to  |
|--|---------------------------------------|------|-----|
| Rodger Collins   |                                       |      |     |
| Darracutt Rd.<br>Aberdeen, Miss. 39730<br>(mailing address)            | Red Clay                              | 0    | 10  |
|  | Sand                                  | 10   | 30  |
|  | Gumbo Sand                            | 30   | 120 |
|  | Sand                                  | 120  | 300 |
| <b>WELL LOCATION:</b>  |                                       |      |     |
| sec. 15 T. 16S N R. 7E E<br>S W  |                                       |      |     |
| 7 miles South of Aberdeen<br>(distance) (direction) (nearest town)     |                                       |      |     |
| <b>WELL PURPOSE:</b> home<br>(home, irrigation, municipal, industrial) |                                       |      |     |
| <b>WELL COMPLETION DATA:</b>   |                                       |      |     |
| (1) diameter (inches) 5"   |                                       |      |     |
| (2) total depth (feet) 300 ft  |                                       |      |     |
| (3) static water level (feet) 86 below above<br>top of ground.         |                                       |      |     |
| (4) casing steel 8" 80 ft<br>(material) (depth)                        |                                       |      |     |
| 5" If telescope see back.<br>(size)                                    |                                       |      |     |
| (5) screen (length) (depth to top)                                     |                                       |      |     |
| (size) (material)  |                                       |      |     |
| (6) pump 1/2 10 gpm<br>(HP) (yield gpm)                                |                                       |      |     |
| elec.<br>(type power)  |                                       |      |     |
| (7) electric log no<br>(yes or no)                                     |                                       |      |     |
| (organization running log)   |                                       |      |     |
| (8) how well bottom plugged open                                       |                                       |      |     |
| <b>DRILLERS REMARKS:</b>   |                                       |      |     |


**CODED**

MAY 11 1972

MISS. BLDG. SE  
 MISSISSIPPI

If well telescopes please  
sketch and show depths.

GROUND LEVEL

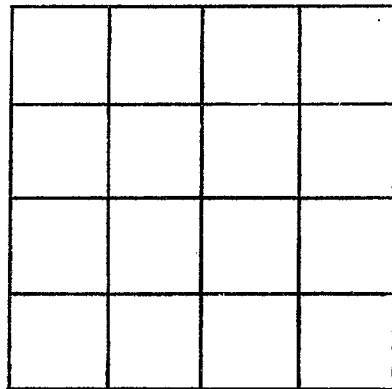

SECTION \_\_\_\_\_

Please indicate well location X.

ADDITIONAL INFORMATION

If more than one screen,  
show locations of each on sketch.