

MONROE
P 54
12-30-72

MISSISSIPPI
BOARD OF WATER COMMISSIONERS
 416 North State Street
 Jackson, Mississippi 39201
WATER WELL DRILLERS LOG

CODED

date well completed: 12-30 1972 Herman Homan Well & Supply, Inc. Monroe county well located
 firm name 42
 SHANNON MISSISSIPPI 38868

LANDOWNER:
E O STAB
Box 4, Aberdeen, Miss
 (mailing address)

description of formations encountered	from	to
<u>Surface sand</u>	<u>0</u>	<u>75</u>
<u>Blue clay</u>	<u>75</u>	<u>120</u>
<u>Sand</u>	<u>120</u>	<u>260</u>
<u>Bottom</u>	<u>260</u>	

WELL LOCATION:
 sec. 23 T. 15 N. R. 7 E.
2 1/2 miles S of Aberdeen
 (distance) (direction) (nearest town)

WELL PURPOSE: Home
 (home, irrigation, municipal, industrial)


- WELL COMPLETION DATA:
- (1) diameter (inches) 4 1/4
 - (2) total depth (feet) 260'
 - (3) static water level (feet) 76' below above top of ground.
 - (4) casing steel 78'
 (material) (depth)
of "
 (size) if telescope see back.
 - (5) screen no
 (length) (depth to top)
 (size) (material)
 - (6) pump 1/2 5
 (HP) (yield gpm)
electric
 (type power)
 - (7) electric log no
 (yes or no)
 (organization running log)
 - (8) how well bottom plugged open

DRILLERS REMARKS:

JAN 2 1973

If well telescopes please sketch and show depths.

GROUND LEVEL

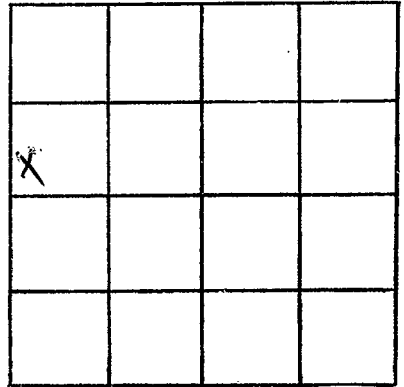

SECTION 23

Please indicate well location X.

ADDITIONAL INFORMATION

If more than one screen,
show locations of each on sketch.