

MONROE
P 55
9-14-72

MISSISSIPPI
BOARD OF WATER COMMISSIONERS
416 North State Street
Jackson, Mississippi 39201

CODED

WATER WELL DRILLERS LOG

9-14 1972 W. J. AEEVES & SON MONROE
date well completed firm name county well located

LANDOWNER: C. B. MITCHELL

Rt. 4 ABERDEEN

(mailing address)

WELL LOCATION:

sec. 24 T. 15 S. R. 7 E.
1 miles SO of ABERDEEN
(distance) (direction) (nearest town)

WELL PURPOSE: HOME
(home, irrigation, municipal, industrial)

WELL COMPLETION DATA:

- (1) diameter (inches) 4
- (2) total depth (feet) 200
- (3) static water level (feet) 100 below top of ground.
- (4) casing ST. 134 1/2 (material) (depth)
- 4 (size) if telescope see back.
- (5) screen NONE (length) (depth to top)
- (size) (material)
- (6) pump 7/4 12 (HP) (yield gpm)
- ELECT (type power)
- (7) electric log NO (yes or no)
- (organization running log)
- (8) how well bottom plugged OPEN


description of formations encountered	from to	
CLAY	0	16
RED SAND	16	19
BLUE CLAY	19	144
" SAND	104	156
" CLAY	156	179
" SAND	179	187
" CLAY	187	202
" SAND	202	200

CODED

DRILLERS REMARKS:

If well telescopes please sketch and show depths.

GROUND LEVEL

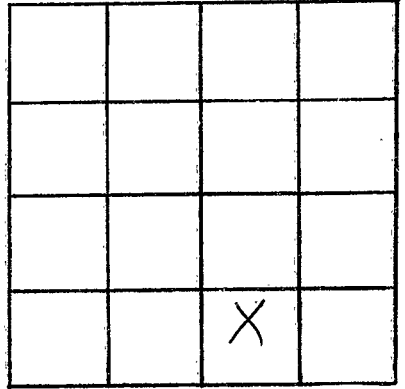

SECTION 4

Please indicate well location X.

ADDITIONAL INFORMATION

If more than one screen,
show locations of each on sketch.