

MONROE
P57

1-18-73

MISSISSIPPI
BOARD OF WATER COMMISSIONERS
416 North State Street
Jackson, Mississippi 39201

WATER WELL DRILLERS LOG

1/18/73 date well completed
Herman Homan Well & Supply, Inc. firm name
42

Monroe county well located

SHANNON, MISSISSIPPI 38600

LANDOWNER:

Kenneth Riley
Rt 4, Aberdeen Miss
(mailing address)

description of formations encountered

from to
surface layer 0 39
Blue clay 34 140
sand 140 280
Botts 260

WELL LOCATION:

sec. 16 T 15 N R 7 E
S W
1.5 miles S.W. of Aberdeen
(distance) (direction) (nearest town)

WELL PURPOSE:

Home
(home, irrigation, municipal, industrial)

WELL COMPLETION DATA:

- (1) diameter (inches) 5"
- (2) total depth (feet) 280'
- (3) static water level (feet) 81' below top of ground.
- (4) casing 5" steel, 37' (material) (depth)
5" if telescope see back. (size)
- (5) screen 20' (length) (depth to top)
(size) (material)
- (6) pump 1/2 HP (HP) 5 (yield gpm)
electric (type power)
- (7) electric log 20 (yes or no)
(organization running log)
- (8) how well bottom plugged open


CODED

FEB 20 1973

DRILLERS REMARKS:

If well telescopes please sketch and show depths.

GROUND LEVEL

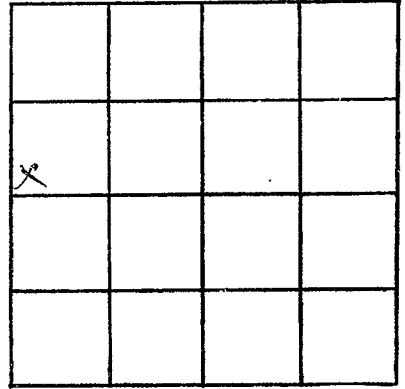

SECTION 16

Please indicate well location X.

ADDITIONAL INFORMATION

If more than one screen,
show locations of each on sketch.