

MONROE
P 59
10-26-73

MISSISSIPPI
 BOARD OF WATER COMMISSIONERS
 416 North State Street
 Jackson, Mississippi 39201

CODED

WATER WELL DRILLERS LOG

Herman Homan Well & Supply, Inc.
 P. O. Box 42

SHANNON, MISSISSIPPI 38668

MONROE county well located

10-26-73
 date well completed

LANDOWNER:
 Pompie Bandle
 Aberdeen Miss.
 (mailing address)

description of formations encountered	from	to
Indian sand		
clay	0	16
Blue clay	16	80
Sand	80	180
Bottom	180	

WELL LOCATION:
 sec. 16 T. 15 N. R. 7 E
 S W
 1 1/4 miles NE of Birtford
 (distance) (direction) (nearest town)

WELL PURPOSE:
 (home, irrigation, municipal, industrial)

- WELL COMPLETION DATA:
- diameter (inches) 5 1/2
 - total depth (feet) 180'
 - static water level (feet) 23' below top of ground.
 - casing steel 21' (material) (depth)
5" (size) if telescope see back.
 - screen NO (length) (depth to top)
(size) (material)
 - pump 1/2 (HP) 5 (yield gpm)
electric (type power)
 - electric log NO (yes or no)
(organization running log)
 - how well bottom plugged open

CODED


DRILLERS REMARKS:

NOV 26 1973

DRIVER CO

If well telescopes please sketch and show depths.

GROUND LEVEL

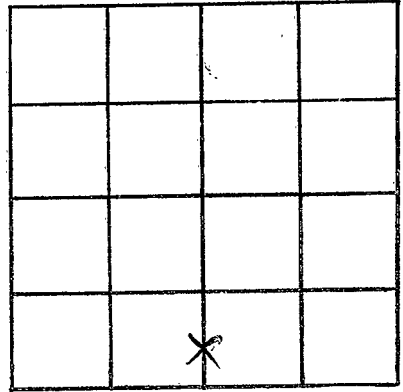

SECTION 16

Please indicate well location X.

ADDITIONAL INFORMATION

If more than one screen, show locations of each on sketch.