

MONROE

P62

5-28-74

MISSISSIPPI  
 BOARD OF WATER COMMISSIONERS  
 416 North State Street  
 Jackson, Mississippi 39201

WATER WELL DRILLERS LOG

Herman Homan Well & Supply, Inc.

P. O. Box 42

SHANNON, MISSISSIPPI 38668

CODED

Monroe

5/28 1974

date well completed

county well located

LANDOWNER:

Robert Hill

Rt. 4, Aberdeen, Miss.  
(mailing address)

WELL LOCATION:

sec. 35 T. 15 N. R. 7 E.  
 S W  
1/2 miles S of Aberdeen  
 (distance) (direction) (nearest town)

WELL PURPOSE:

(home, irrigation, municipal, industrial) Home

WELL COMPLETION DATA:

- (1) diameter (inches) 4"
- (2) total depth (feet) 260'
- (3) static water level (feet) 119' below top of ground.
- (4) casing Steel, 105' (material), (depth)  
4" (size) If telescope see back.
- (5) screen no, (length), (depth to top)  
 (size), (material)
- (6) pump 3/4, 7 (HP), (yield gpm)  
electric (type power)
- (7) electric log No (yes or no)  
 (organization running log)
- (8) how well bottom plugged open


description of formations encountered

from

to

surface sand 0 100  
blue clay 100 140  
sand 140 260  
Bottom 260

CODE

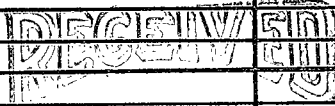

DRILLERS REMARKS:

If well telescopes please sketch and show depths.

GROUND LEVEL

		X	

SECTION 35

Please indicate well location X.

ADDITIONAL INFORMATION

If more than one screen,  
show locations of each on sketch.