

MONROE  
P63  
6-4-74

MISSISSIPPI  
BOARD OF WATER COMMISSIONERS  
416 North State Street  
Jackson, Mississippi 39201

WATER WELL DRILLERS LOG

CODED

Herman Heman Well & Supply, Inc.

Monroe

6/4 1974  
date well completed

P.O. Box 42  
SHANNON, MISSISSIPPI 38868

county well located

LANDOWNER:

description of formations encountered

from to

Nesley Jordan  
Rt. 4, Aberdeen, Miss.  
(mailing address)

Surface sand & clay	0	100
Blue clay	100	140
Sand	140	260
Bathurst	260	

WELL LOCATION:

sec. 35 T. 15 N. R. 7 E  
S S  
5 miles S of Aberdeen  
(distance) (direction) (nearest town)

WELL PURPOSE:  
(home, irrigation, municipal, industrial)

WELL COMPLETION DATA:

- (1) diameter (inches) 4"
- (2) total depth (feet) 260'
- (3) static water level (feet) 106' below top of ground.
- (4) casing steel, 106' (material) (depth)  
4" (size) if telescope see back.
- (5) screen no (length) (depth to top)  
(size) (material)
- (6) pump 3/4 (HP) 5 (yield gpm)  
electric (type power)
- (7) electric log no (yes or no)  
(organization running log)
- (8) how well bottom plugged open

CODED


DEGENWISER

JUL - 1 1974

DRILLERS REMARKS:

If well telescopes please sketch and show depths.

GROUND LEVEL

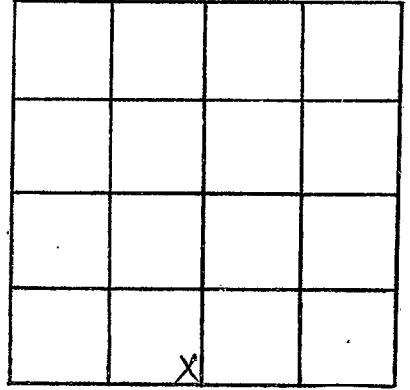

SECTION 35

Please indicate well location X.

ADDITIONAL INFORMATION

If more than one screen,  
show locations of each on sketch.