

**MONROE**  
**P 64**  
**7-6-74**

**MISSISSIPPI**  
**BOARD OF WATER COMMISSIONERS**  
 416 North State Street  
 Jackson, Mississippi 39201

**CODED**

**WATER WELL DRILLERS LOG**

Herman Homan Well & Supply, Inc.  
 P. O. Box 42

7-5 1974 date well completed  
 SHANNON, MISSISSIPPI 38668  
 Monroe county well located

**LANDOWNER:**  
 Peaslean Jones  
 Rt 9, Aberdeen Miss.  
 (mailing address)

description of formations encountered	from	to
Surface sand & clay	0	10
White clay	10	60
Sand	60	200
Bottom	200	

**WELL LOCATION:**  
 sec. 16 T. 15 N R. 2 E  
 S W  
 2 miles SW of Aberdeen  
 (distance) (direction) (nearest town)

**WELL PURPOSE:**  
 Home  
 (home, irrigation, municipal, industrial)

- WELL COMPLETION DATA:**
- (1) diameter (inches) 4"
  - (2) total depth (feet) 200'
  - (3) static water level (feet) 35' below top of ground.
  - (4) casing steel, 15' (material) (depth)  
 4" if telescope see back. (size)
  - (5) screen ND (length) (depth to top)  
 (size) (material)
  - (6) pump 1/2 (HP) 5 (yield gpm)  
 electric (type power)
  - (7) electric log ND (yes or no)  
 (organization running log)
  - (8) how well bottom plugged yes


**CODED**

**RECEIVED**  
**INDEXED**  
**AUG - 8 1974**

**DRILLERS REMARKS:**

If well telescopes please sketch and show depths.

GROUND LEVEL

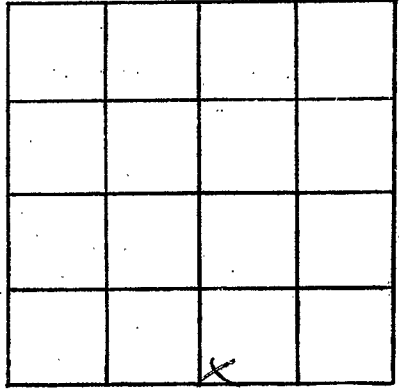

SECTION 16

Please indicate well location X.

ADDITIONAL INFORMATION

If more than one screen, show locations of each on sketch.