

MONROE  
P 65  
7-29-74

MISSISSIPPI  
BOARD OF WATER COMMISSIONERS  
416 North State Street  
Jackson, Mississippi 39201

CODED

WATER WELL DRILLERS LOG

7-29 1974 Herman Homan Well & Supply, Inc.  
date well completed P.O. Box 42  
firm name  
SHANNON MISSISSIPPI 38468 Monroe  
county well located

LANDOWNER:  
Al Jordan  
Rt 4 Abbeville Miss  
(mailing address)

description of formations encountered	from	to
Sand	0	93
Clay	93	100
Blue clay	190	260
Sand	260	

WELL LOCATION:  
sec. 34 T 15 N R 7 E  
S W  
5 miles 5 of Abbeville  
(distance) (direction) (nearest town)

WELL PURPOSE: Home  
(home, irrigation, municipal, industrial)

- WELL COMPLETION DATA:
- (1) diameter (inches) 4"
  - (2) total depth (feet) 260'
  - (3) static water level (feet) 93' below above top of ground.
  - (4) casing steel, 105'  
(material) (depth)  
4" if telescope see back.  
(size)
  - (5) screen rd  
(length) (depth to top)  
(size) (material)
  - (6) pump 3/4 7  
(HP) (yield gpm)  
electric  
(type power)
  - (7) electric log rd  
(yes or no)  
(organization running log)
  - (8) how well bottom plugged yca

DRILLERS REMARKS:

CODED


RECEIVED

AUG - 8 1974

MISS. BD. OF WATER COMMISSIONERS

If well telescopes please sketch and show depths.

GROUND LEVEL

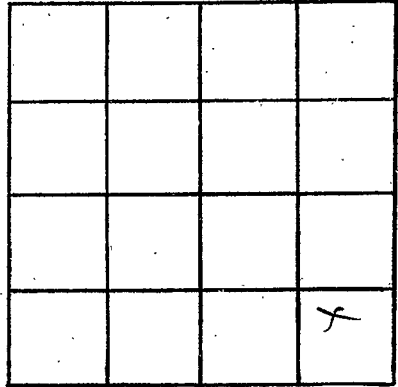

SECTION 34

Please indicate well location X.

ADDITIONAL INFORMATION

If more than one screen, show locations of each on sketch.