

MONROE  
P 66  
7-26-74

MISSISSIPPI  
BOARD OF WATER COMMISSIONERS  
416 North State Street  
Jackson, Mississippi 39201

CODED

WATER WELL DRILLERS LOG

Herman Homan Well & Supply, Inc.

P.O. Box 42

SHANNON, MISSISSIPPI 38688


Monroe

7/26 1974  
date well completed

county well located

LANDOWNER:	description of formations encountered	from	to
James Nixon RT 2 Aberdeen, Miss. (mailing address)	Surface sand & clay Blue clay Sand Bottom	0 150 150 260	100 140 260
WELL LOCATION: sec. 35 T. 15 N. R. 7 E S 5 1/2 miles S of Aberdeen (distance) (direction) (nearest town)			
WELL PURPOSE: (home, irrigation, municipal, industrial)			
WELL COMPLETION DATA:			
(1) diameter (inches) 4"			
(2) total depth (feet) 260'			
(3) static water level (feet) 112' below top of ground			
(4) casing steel 105' 10" (material) (depth) 4" If telescope see back. (size)			
(5) screen NO (length) (depth to top) (size) (material)			
(6) pump 3/4 7 (HP) (yield gpm) electric (type power)			
(7) electric log NO (yes or no)			
(organization running log)			
(8) how well bottom plugged open			
DRILLERS REMARKS:			

CODED

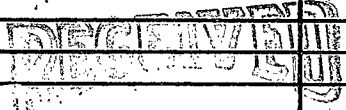


AUG - 8 1974

MISS. BD. OF WATER COMM.

If well telescopes please sketch and show depths.

GROUND LEVEL

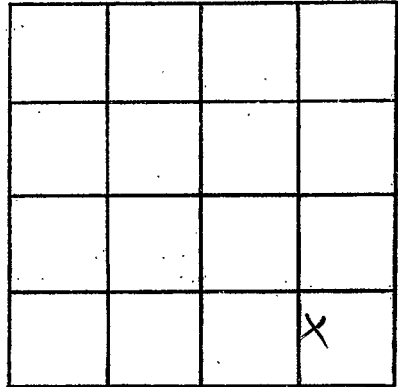

SECTION 35

Please indicate well location X.

ADDITIONAL INFORMATION

If more than one screen, show locations of each on sketch.