

MONROE
P 67
5-2-75

MISSISSIPPI
BOARD OF WATER COMMISSIONERS
416 North State Street
Jackson, Mississippi 39201

CODED

WATER WELL DRILLERS LOG

Herman Homan Well & Supply, Inc. 021

5/2 1975 P. O. Box 42 Monroe
date well completed firm name county well located
SHANNON, MISSISSIPPI 38268


LANDOWNER:	description of formations encountered	from	to
James Foote Rt 4, Aberdeen, Miss (mailing address)			
WELL LOCATION: sec. 3 T. 16 N R. 7 E S S 5 miles S of Aberdeen (distance) (direction) (nearest town)			
WELL PURPOSE: (home, irrigation, municipal, industrial)			
WELL COMPLETION DATA:			
(1) diameter (inches) 4"			
(2) total depth (feet) 240'			
(3) static water level (feet) 81' below top of ground.			
(4) casing steel 105' (material) (depth) 4" if telescope see back. (size)			
(5) screen no (length) (depth to top) (size) (material)			
(6) pump 1/2 HP 5 (type power) (yield gpm)			
(7) electric log no (yes or no)			
(organization running log)			
(8) how well bottom plugged JTC			
DRILLERS REMARKS:			

RECEIVED
MAY 19 1975

MISS. Bd. of WATER COMMISSIONERS

If well telescopes please sketch and show depths.

GROUND LEVEL

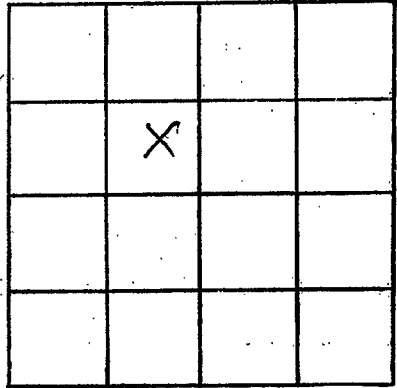

SECTION 3

Please indicate well location X.

ADDITIONAL INFORMATION

If more than one screen, show locations of each on sketch.