

MONROE

P 69

2/9/78

MISSISSIPPI BOARD OF WATER COMMISSIONERS  
416 North State Street  
Jackson, Mississippi 39201

CODED

WATER WELL DRILLERS LOG

2/9/78  
date well completed

Griner Drilling Service  
firm name

Monroe Co  
county well located

LANDOWNER: Pan Exploration

#1 W.R. Thomas

description of formations encountered

from to

heavy clay	0	30
clay & sand	30	200
sand	200	225
clay & sand	225	570

(mailing address)

WELL LOCATION:

sec. 5 T 15 N R 7 E

2300' N + 1500' W of SE corner of West Point  
miles (distance) of (direction) (nearest town)

WELL PURPOSE: Oil Well Supply  
(home, irrigation, municipal, industrial)

WELL COMPLETION DATA:

- (1) diameter (inches) 3"
- (2) total depth (feet) 570
- (3) static water level (feet) 70 below top of ground.
- (4) casing Steel 350' (material), (depth)  
3" (size) if telescope see back.
- (5) screen 21' 205' (length), (depth to top)  
3" Perforated Pipe (size), (material)
- (6) pump (HP) 85 (yield gpm)  
AC (type power)
- (7) electric log NO (yes or no)  
NA (organization running log)
- (8) how well bottom plugged orange  
peel

DRILLERS REMARKS:


RECEIVED

MAR 10 1978

MISS. BD. OF WATER COMM

If well telescopes please sketch and show depths.

GROUND LEVEL

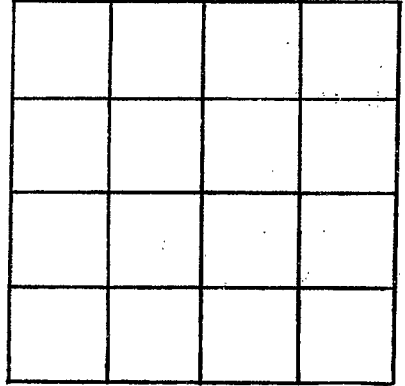

SECTION \_\_\_\_\_

Please indicate well location X.

ADDITIONAL INFORMATION

If more than one screen,  
show locations of each on sketch.