

MONROE
P 70
6/1/79

MISSISSIPPI
BOARD OF WATER COMMISSIONERS
416 North State Street
Jackson, Mississippi 39201

Dist. for copy
6/3/79
Rud Bault
July 2006

WATER WELL DRILLERS LOG

6/1/79 19 GRANITE CONST CO MONROE
date well completed firm name county well located

LANDOWNER:	description of formations encountered	from	to
BILL McALESTER		TOP	20'
Hwy 45 ABERDEEN MS (mailing address)	SANDY MTL		
WELL LOCATION: sec 25 T 15 S R 7 E 4 miles S of ABERDEEN (distance) (direction) (nearest town)	RYAN FORMATION	20'	140'
WELL PURPOSE: IRRIGATION (home, irrigation, municipal, industrial)			
WELL COMPLETION DATA:			
(1) diameter (inches) 16			
(2) total depth (feet) 140			
(3) static water level (feet) 10 below top of ground.			
(4) casing (material) PVC (depth) 110 6" (size) If telescope see back.			
(5) screen (length) 50' (depth to top) 110 6" (size) PVC (material)			
(6) pump (HP) 5 (yield gpm) 100			
Joe ZID (type power)			
(7) electric log (yes or no) NO			
(organization running log)			
(8) how well bottom plugged PVC CAP			
DRILLERS REMARKS: UNEVENTFUL			

Miss. Board of Water Comm.

JUN - 8 1979

RECEIVED

(X)

If well telescopes please sketch and show depths.

GROUND LEVEL


16" WELL

6" CBING PVC

110'

6" SCREEN SLOTT 0.020 PVC

140'

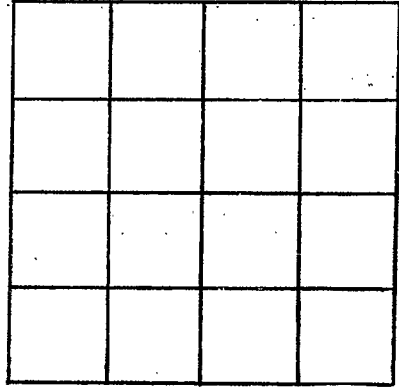

SECTION _____

Please indicate well location X.

ADDITIONAL INFORMATION

Lined area for additional information.

If more than one screen, show locations of each on sketch.