

MONROE
P-71
1-7-80

MISSISSIPPI
BOARD OF WATER COMMISSIONERS
416 North State Street
Jackson, Mississippi 39201

CODED

WATER WELL DRILLERS LOG

1-7-80 Griner Drilling Monroe
date well completed firm name county well located

LANDOWNER:

Patrick Oil Corporation

description of formations encountered

from to

Clay 0 210
Clay + sand 210 394
Clay 394 357
sand 357 420

(mailing address)

WELL LOCATION: 990' N + 1920' E

sec. 6 T 15 N R 7 E O 4

Aberdeen (distance) miles (direction) of (nearest town)

WELL PURPOSE: oil field supply
(home, irrigation, municipal, industrial)

WELL COMPLETION DATA:

- (1) diameter (inches) 3"
- (2) total depth (feet) 425'
- (3) static water level (feet) 100' below top of ground.
- (4) casing steel, 420' (material) (depth)
- 42' (size) if telescope see back.
- (5) screen 42' (length), 378' (depth to top)
- 3" perforated (size) (material)
- (6) pump (HP) 70 (yield gpm)
- AC (type power)
- (7) electric log (yes or no)

(organization running log)

(8) how well bottom plugged orange peel

DRILLERS REMARKS:

DEPT. OF NATURAL RESOURCES
BUREAU OF LAND & WATER RESOURCES


JAN 24 1980

RECEIVED

No 1
Unit 4
6-14

If well telescopes please sketch and show depths.

GROUND LEVEL

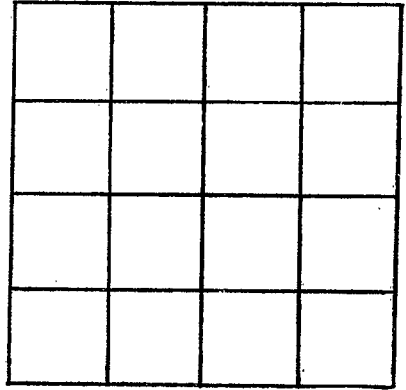

SECTION _____

Please indicate well location X.

ADDITIONAL INFORMATION

If more than one screen, show locations of each on sketch.