

MISSISSIPPI DEPARTMENT OF NATURAL RESOURCES

Bureau of Land and Water Resources

Southport Mall

P.O. Box 10631

Jackson, Mississippi 39209

WATER WELL DRILLERS LOG

CODED

MONROE
P 74
12/9/81

Griner Drilling Service, Inc.

Monroe

12-9-81
date well completed

firm name

county well located

LANDOWNER:

Pruet Production
1515 Capital Towers
Jackson, Ms. 39205
(mailing address)

description of formations encountered

from

to

chalk	0	126
sand	126	168
chalk, rock	168	252
chalk	252	357
chalk, rock	357	399
streaked sand	399	483
sand	483	525

WELL LOCATION:

1978'S + 1000' E

NOT a
unit

27 T-15 N R-7 E
4-27 miles (distance) of (direction) of (nearest town)

WELL PURPOSE: oil field supply
(home, irrigation, municipal, industrial)

WELL COMPLETION DATA:

- (1) diameter (inches) 3"
- (2) total depth (feet) 525'
- (3) static water level (feet) 120' below top of ground.
- (4) casing steel, 525' (material), (depth)
3" (size) if telescope see back.
- (5) screen 42' (length), 489' (depth to top)
3" (size) (material)
- (6) pump (HP) 70 (yield gpm)
AC (type power)
- (7) electric log (yes or no)
- (organization running log)

CODED

(8) how well bottom plugged orange peel

DRILLERS REMARKS:


DEPT. OF NATURAL RESOURCES
BUREAU OF LAND & WATER RESOURCES

JAN 15 1982

RECEIVED

If well telescopes please sketch and show depths.

GROUND LEVEL

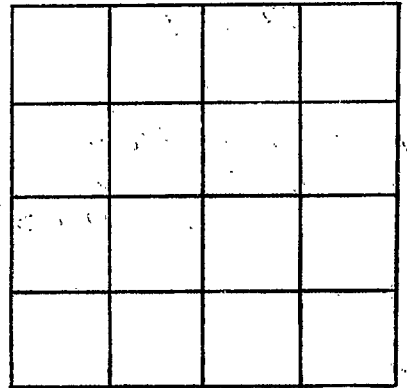

SECTION _____

Please indicate well location X.

ADDITIONAL INFORMATION

If more than one screen,
show locations of each on sketch.