

MISSISSIPPI DEPARTMENT OF NATURAL RESOURCES

Bureau of Land and Water Resources

Southport Mall

P.O. Box 10631

Jackson, Mississippi 39209

WATER WELL DRILLERS LOG

Griner Drilling Service, Inc.

Monroe

MONROE
P 75
4-8-82

4-8-82 date well completed

Griner Drilling Service, Inc. firm name

Monroe county well located

LANDOWNER:  
 Pruet Production  
 1515 Capital Towers  
 Jackson, MS. 39205  
 (mailing address)

description of formations encountered

from

to

Hard chalk

0

315

lime rock, sand, streaks of chalk

315

378

chalk, rock

378

462

sand, little peagravel

462

504

WELL LOCATION: 1000' N + 2000' E  
 sec. 8 T-16 R-7 S-10 W-10  
 Richard C. Bryan 8-14 Strong Field  
 (distance) (direction) (nearest town)

WELL PURPOSE: oil field supply  
 (home, irrigation, municipal, industrial)

WELL COMPLETION DATA:

- (1) diameter (inches) 3"
- (2) total depth (feet) 504'
- (3) static water level (feet) 50' (below) above top of ground.
- (4) casing steel 315'  
 (material) (depth)  
3" if telescope see back.  
 (size)
- (5) screen NONE - OPEN  
 (length) (depth to top)  
Ended Well  
 (size) (material)
- (6) pump — 60  
 (HP) (yield gpm)  
AC  
 (type power)
- (7) electric log —  
 (yes or no)  
 (organization running log)
- (8) how well bottom plugged open  
ended

DEPT. OF NATURAL RESOURCES  
 BUREAU OF LAND & WATER RESOURCES


APR 27 1982

RECEIVED

DRILLERS REMARKS:

If well telescopes please sketch and show depths.

GROUND LEVEL

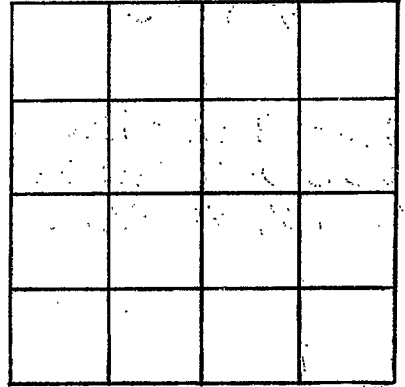

SECTION \_\_\_\_\_

Please indicate well location X.

ADDITIONAL INFORMATION

If more than one screen,  
show locations of each on sketch.