

**MISSISSIPPI
BOARD OF WATER COMMISSIONERS**
416 North State Street
Jackson, Mississippi 39201

WATER WELL DRILLERS LOG

MONROE
P 2000
2-67

2-13 1967 W.J. REEVES & SON MONROE
date well completed firm name county well located

LANDOWNER: CHARLES WILSON

description of formations encountered	from	to

ABERDEEN, MISS.
(mailing address)


WELL LOCATION:
sec. 15 T. 15 S. R. 8 E.
6 5
2 miles SE of ABERDEEN
(distance) (direction) (nearest town)

SANDY SOIL	0	4
CLAY	4	14
RED SAND	14	35
BLUE CLAY	35	60
" SAND	60	81
" CLAY	81	115
" SAND	115	126
" CLAY	126	134
" SAND	134	138
" CLAY	138	152
BLUE SAND & CLAY	152	170
BLUE CLAY	170	185
" SAND	185	198
" CLAY	198	200

WELL PURPOSE: FARM
(home, irrigation, municipal, industrial)

WELL COMPLETION DATA:

- (1) diameter (inches) 4
- (2) total depth (feet) 200
- (3) static water level (feet) 8 below top of ground.
- (4) casing STEEL, 43' (material) (depth)
4 (size) if telescope see back.
- (5) screen NONE (length) (depth to top)
(size) (material)
- (6) pump NONE (HP) (yield gpm)
(type power)
- (7) electric log NO (yes or no)
(organization running log)
- (8) how well bottom plugged OPEN

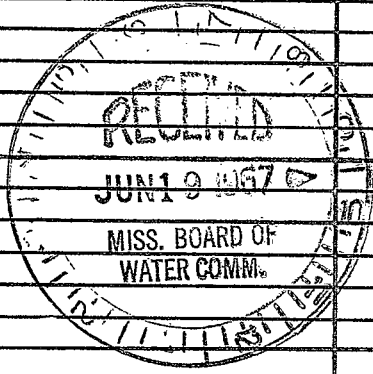

DRILLERS REMARKS:

