

Monroe

P 2001

11-20-75

MISSISSIPPI
 BOARD OF WATER COMMISSIONERS
 416 North State Street
 Jackson, Mississippi 39201

13L

WATER WELL DRILLERS LOG


11/20 1975
date well completed

Herman Homan Well & Supply, Inc.

P. O. BOX 42
firm name


QUANNON, MISSISSIPPI 38168

Monroe
county well located

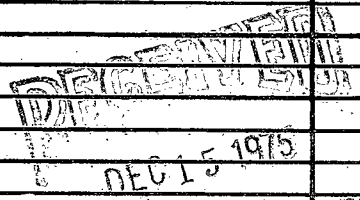LANDOWNER:	description of formations encountered	from	to
David Dahlem	Surface sand & clay	0	45
Aberdeen, Miss. (mailing address)	Blue clay Sand	95	120
WELL LOCATION:	Both	120	240
sec. 26 T. 15 N. R. 7 E. S. # 4 miles South of Aberdeen (distance) (direction) (nearest town)			
WELL PURPOSE: (home, irrigation, municipal, industrial)			
WELL COMPLETION DATA:			
(1) diameter (inches) 4"			
(2) total depth (feet) 240			
(3) static water level (feet) 105 below top of ground.			
(4) casing (material) (depth) steel, 105'			
(size) 4" if telescope see back.			
(5) screen (length) (depth to top) 20'			
(size) (material)		320	
(6) pump (HP) (yield gpm) 1/2 5		105	
(type power) elect		215	
(7) electric log (yes or no) no			
(organization running log)			
(8) how well bottom plugged 0/10			
DRILLERS REMARKS:			

If well telescopes please sketch and show depths.

GROUND LEVEL

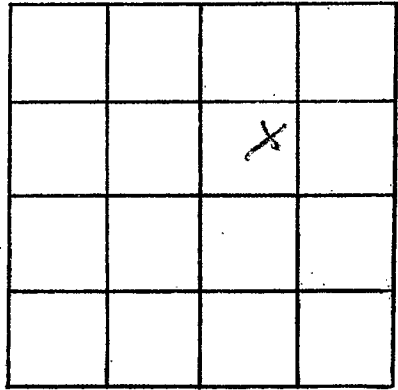

SECTION 26

Please indicate well location X.

ADDITIONAL INFORMATION

If more than one screen,
show locations of each on sketch.