

MONROE
 P 2003
 6-23-77

MISSISSIPPI
 BOARD OF WATER COMMISSIONERS
 416 North State Street
 Jackson, Mississippi 39201

WATER WELL DRILLERS LOG

date well completed 6-23-77 19 77 firm name Herman Homan Well & Supply, Inc. county well located MONROE
 P.O. BOX 42
 SHANNON MISSISSIPPI 38562

LANDOWNER:

Kenneth James
Rt 3 Aberdeen
 (mailing address) Ms.

description of formations encountered

from to

<u>surface sand</u>	<u>0</u>	<u>100</u>
<u>clay</u>	<u>100</u>	<u>110</u>
<u>blm clay</u>	<u>110</u>	<u>240</u>
<u>sand</u>	<u>110</u>	<u>240</u>
<u>blm</u>	<u>240</u>	

WELL LOCATION:

sec. 35 T 15 N R 7 E
4E miles 5 of Aberdeen
 (distance) (direction) (nearest town)

WELL PURPOSE:

Home
 (home, irrigation, municipal, industrial)

WELL COMPLETION DATA:

- (1) diameter (inches) 4 1/2"
- (2) total depth (feet) 240'
- (3) static water level (feet) 137' below above top of ground.
- (4) casing Steel (material) 104' (depth)
4" (size) if telescope see back.
- (5) screen 10' (length) (depth to top)
 (size) (material)
- (6) pump 1/2 (HP) 5 (yield gpm)
electric (type power)
- (7) electric log no (yes or no)

(organization running log)

- (8) how well bottom plugged open

DRILLERS REMARKS:


RECEIVED

JUL 25 1977

MISS. BB. OF WATER COMMISSIONERS

If well telescopes please sketch and show depths.

GROUND LEVEL

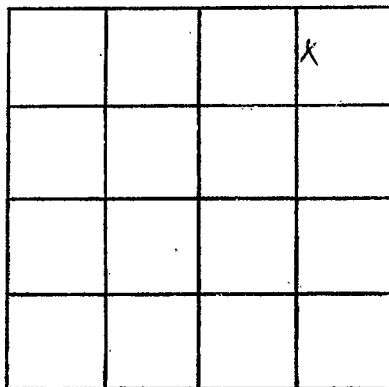

SECTION 5K

Please indicate well location X.

ADDITIONAL INFORMATION

If more than one screen, show locations of each on sketch.