

MONROE
 P 2004
 8-31-77

MISSISSIPPI
 BOARD OF WATER COMMISSIONERS
 416 North State Street
 Jackson, Mississippi 39201

WATER WELL DRILLERS LOG

8-31-77 date well completed 1977 Herman Homan Well & Supply, Inc. firm name 42 MONROE county well located
 SHANNON MISSISSIPPI 38868

LANDOWNER:
 Ribbon Jackson
 Rt 4 Aberdeen, Md
 (mailing address)

description of formations encountered	from	to
Surface road &		
Clay	0	100
Blue clay	100	120
Sand	120	260
Gravel	260	

WELL LOCATION:
 sec. 35 T. 165 N. R. 7 E
 S W
 5 miles S of Aberdeen
 (distance) (direction) (nearest town)

WELL PURPOSE: Home
 (home, irrigation, municipal, industrial)

WELL COMPLETION DATA:

(1) diameter (inches) 4"

(2) total depth (feet) 260

(3) static water level (feet) 120 below above top of ground.

(4) casing (material) 5 steel, 105' (depth) (depth)
 4" if telescope see back. (size)

(5) screen 20 (length) (depth to top) (size) (material)

(6) pump 1/2 (HP) 5 (yield gpm) (type power) elect

(7) electric log NO (yes or no)

(organization running log)

(8) how well bottom plugged


DRILLERS REMARKS:

RECEIVED
 SEP 7 1977

MISS. BD. OF WATER COMMISSIONERS

If well telescopes please sketch and show depths.

GROUND LEVEL

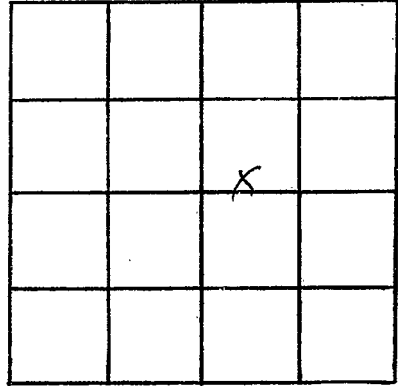

SECTION 35

Please indicate well location X.

ADDITIONAL INFORMATION

If more than one screen, show locations of each on sketch.