

MONROE

P 2006

11/4/77

MISSISSIPPI BOARD OF WATER COMMISSIONERS 416 North State Street Jackson, Mississippi 39201

WATER WELL DRILLERS LOG

11-4 1977 WJ REEVES & SON MONROE date well completed firm name county well located

LANDOWNER: BOBBY WATKINS P.O. Box 813 ABERDEEN (mailing address)

Table with 3 columns: description of formations encountered, from, to. Rows include CLAY, BLUE SANDY CLAY, SAND & CLAY, SAND.

WELL LOCATION: sec. 4 T 15 S R 7 E 1/2 miles So of ABERDEEN (distance) (direction) (nearest town)

WELL PURPOSE: HOME (home, irrigation, municipal, industrial)

- WELL COMPLETION DATA: (1) diameter (inches) 4 (2) total depth (feet) 240 (3) static water level (feet) 110 below top of ground. (4) casing PVC 220 (material) (depth) 4 (size) if telescope see back. (5) screen 20 220 (length) (depth to top) 4 PVC (size) (material) (6) pump 3/4 1.5 (HP) (yield gpm) ELECT (type power) (7) electric log No (yes or no) (organization running log) (8) how well bottom plugged WOOD

RECEIVED


APR 18 1978

DRILLERS REMARKS:

MISS. BD. OF WATER COMM

If well telescopes please sketch and show depths.

GROUND LEVEL

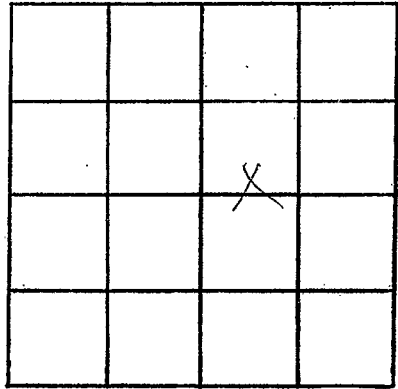

SECTION 4

Please indicate well location X.

ADDITIONAL INFORMATION

If more than one screen, show locations of each on sketch.