

Monroe  
P 2007  
12/16/77

MISSISSIPPI  
BOARD OF WATER COMMISSIONERS  
416 North State Street  
Jackson, Mississippi 39201

WATER WELL DRILLERS LOG

Herman Homan Well & Supply, Inc.

P. O. Box 42

SHANNON, MISSISSIPPI 38268

Monroe

12-16-1977  
date well completed

county well located

LANDOWNER:  
Movel Feas  
At 1 Practice Ms  
(mailing address)

description of formations encountered	from	to
Surface sand		
Blue clay	0	18
Sand	18	220
Bottom	220	360

WELL LOCATION:  
sec. 30 T. 15 N. R. 6 E  
S W  
4 miles NE of Madison  
(distance) (direction) (nearest town)

WELL PURPOSE: Home  
(home, irrigation, municipal, industrial)

- WELL COMPLETION DATA:
- (1) diameter (inches) 4"
  - (2) total depth (feet) 360'
  - (3) static water level (feet) 87' below top of ground.
  - (4) casing Steel 20'  
(material) (depth)
  - 4" If telescope see back.  
(size)
  - (5) screen no  
(length) (depth to top)
  - (size) (material)
  - (6) pump 1/2 5  
(HP) (yield gpm)
  - electric  
(type power)
  - (7) electric log no  
(yes or no)
  - (organization running log)
  - (8) how well bottom plugged open

DRILLERS REMARKS:


RECEIVED

DEC 22 1977

MISS. BD. OF WATER COMM

If well telescopes please sketch and show depths.

GROUND LEVEL

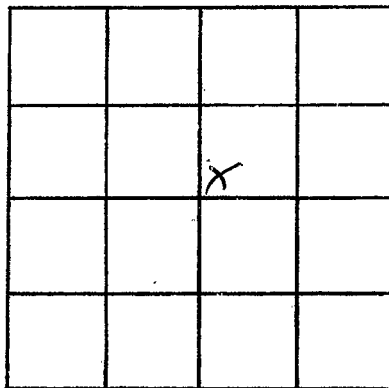

SECTION 30

Please indicate well location X.

ADDITIONAL INFORMATION

If more than one screen,  
show locations of each on sketch.