

MONROE

P 2009

4-12-78

MISSISSIPPI BOARD OF WATER COMMISSIONERS  
416 North State Street  
Jackson, Mississippi 39201

WATER WELL DRILLERS LOG

Herman Homan Well & Supply, Inc.

P. O. Box 42

SHANNON, MISSISSIPPI 38868

Monroe

4/12 1978  
date well completed

county well located

LANDOWNER:

Baibee & Chapman  
294 A Aberdeen Ms.  
(mailing address)

description of formations encountered

from to

surface clay 0 1.6  
blue clay 1.6 1.9  
sand 1.9 2.8  
2.8

WELL LOCATION:

sec. 17 T. 16 N. R. 7 E  
S W  
1 miles E of Stoughton  
(distance) (direction) (nearest town)

WELL PURPOSE:

Home  
(home, irrigation, municipal, industrial)

WELL COMPLETION DATA:

- (1) diameter (inches) 4"
- (2) total depth (feet) 280'
- (3) static water level (feet) 50' below top of ground.
- (4) casing (material) steel, (depth) 214'
- 4" (size) If telescope see back.
- (5) screen (length) 20' (depth to top)
- (size) (material)
- (6) pump (HP) 7 (yield gpm)
- electric (type power)
- (7) electric log (yes or no)

(organization running log)

(8) how well bottom plugged open


DRILLERS REMARKS:

RECEIVED  
JUN - 6 1978

MISS. BD. OF WATER COMM.

If well telescopes please sketch and show depths.

GROUND LEVEL

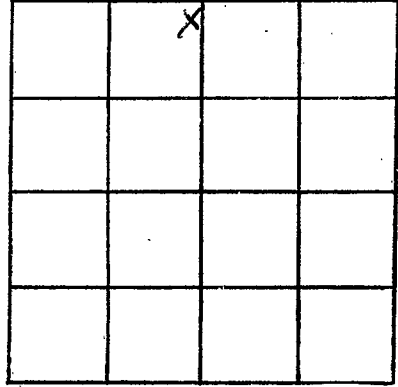

SECTION 17

Please indicate well location X.

ADDITIONAL INFORMATION

If more than one screen,  
show locations of each on sketch.