

MONROE
 P 2010
 4-22-78

MISSISSIPPI
 BOARD OF WATER COMMISSIONERS
 416 North State Street
 Jackson, Mississippi 39201

WATER WELL DRILLERS LOG

Herman Homan Well & Supply, Inc.

P. O. Box 42

SHANNON, MISSISSIPPI 38860

Monroe
 county well located

4-22-78
 date well completed

LANDOWNER:
 David Waldrop
 Aberdeen, MS.
 (mailing address)

WELL LOCATION:
 sec. 26 T. 15 N. R. 7 E
 3 1/2 miles S of Aberdeen
 (distance) (direction) (nearest town)

WELL PURPOSE: Home
 (home, irrigation, municipal, industrial)

- WELL COMPLETION DATA:
- diameter (inches) 4 1/2
 - total depth (feet) 260'
 - static water level (feet) 100' below top of ground
 - casing (material) steel, (depth) 106' 4"
 - screen (size) 4 1/2" (length) 10' (depth to top)
 - pump (HP) 1/2 (yield gpm) 5
 (type power) electric
 - electric log (yes or no) no
 - organization running log
 - how well bottom plugged open

DRILLERS REMARKS:

description of formations encountered	from	to
Surface Sand	0	90
Blue clay	90	120
Sand	120	260
Bottom	260	


RECEIVED

JUN - 6 1978

MISS. BD. OF WATER COMMISSIONERS

If well telescopes please sketch and show depths.

GROUND LEVEL

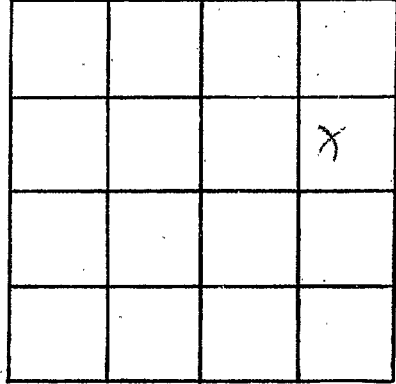

SECTION 26

Please indicate well location X.

ADDITIONAL INFORMATION

If more than one screen, show locations of each on sketch.