

MONROE  
P 201

MISSISSIPPI  
BOARD OF WATER COMMISSIONERS  
416 North State Street  
Jackson, Mississippi 39201

WATER WELL DRILLERS LOG

Herman Homan Well & Supply, Inc.

P. O. Box 42

SHANNON, MISSISSIPPI 38268

7-28-78 1978  
date well completed

Monroe  
county well located

LANDOWNER:  
Don Gibson  
Ref Aberdeen Ms  
(mailing address)

description of formations encountered	from	to
surface sand	0	60
clay	60	140
blue clay	140	260
sand	260	
bottom	260	

WELL LOCATION:  
sec. 10 T 15 N R 7 E  
S W  
1.7 miles NE of Bristow  
(distance) (direction) (nearest town)

WELL PURPOSE: Home  
(home, irrigation, municipal, industrial)

WELL COMPLETION DATA:

(1) diameter (inches) 4"

(2) total depth (feet) 260'

(3) static water level (feet) 103' below above top of ground.

(4) casing steel 667' (material) (depth)  
4" (size) if telescope see back.

(5) screen 20' (length) (depth to top)  
(size) (material)

(6) pump 1/2 (HP) 5 (yield gpm)  
electric (type power)

(7) electric log 40 (yes or no)  
(organization running log)

(8) how well bottom plugged open


DRILLERS REMARKS:

RECEIVED  
AUG - 3 1978

MISS. BD. OF WATER COMM.

If well telescopes please sketch and show depths.

GROUND LEVEL

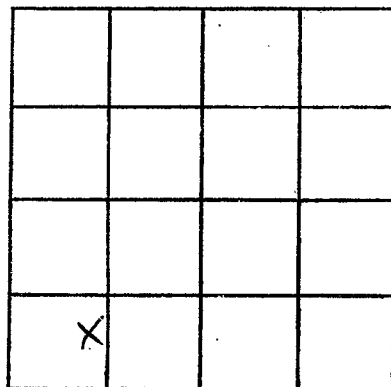

SECTION 15

Please indicate well location X.

ADDITIONAL INFORMATION

A series of horizontal lines for writing additional information.

If more than one screen, show locations of each on sketch.