

MONROE
 P 2012
 11-24-78

MISSISSIPPI
 BOARD OF WATER COMMISSIONERS
 416 North State Street
 Jackson, Mississippi 39201

WATER WELL DRILLERS LOG

11/29 1978 Herman Homan Well & Supply, Inc. *Monroe*
 date well completed firm name county well located
 SHANNON MISSISSIPPI 39168

LANDOWNER:
Ruby Allen
Rt 4 Aberdeen MS
 (mailing address)

description of formations encountered	from	to
<i>Surface sand</i>	<i>0</i>	<i>100</i>
<i>clay</i>	<i>100</i>	<i>120</i>
<i>Blue clay</i>	<i>120</i>	<i>240</i>
<i>Sand</i>	<i>175</i>	<i>240</i>
<i>Bottom</i>	<i>240</i>	

WELL LOCATION:
 sec. *23* T. *15* N. R. *7* E
3 miles *E* of *Binford*
 (distance) (direction) (nearest town)

WELL PURPOSE: *Home*
 (home, irrigation, municipal, industrial)

- WELL COMPLETION DATA:
- (1) diameter (inches) *4"*
 - (2) total depth (feet) *240'*
 - (3) static water level (feet) *111* below above top of ground.
 - (4) casing *steel*, *106'*
 (material) (depth)
4" If telescope see back.
 (size)
 - (5) screen *no*,
 (length) (depth to top)
 (size) (material)
 - (6) pump *1/2* *5*
 (HP) (yield gpm)
electric
 (type power)
 - (7) electric log *no*
 (yes or no)
 - (organization running log)
 - (8) how well bottom plugged *open*


DRILLERS REMARKS:

RECEIVED

DEC 27 1978

If well telescopes please sketch and show depths.

GROUND LEVEL

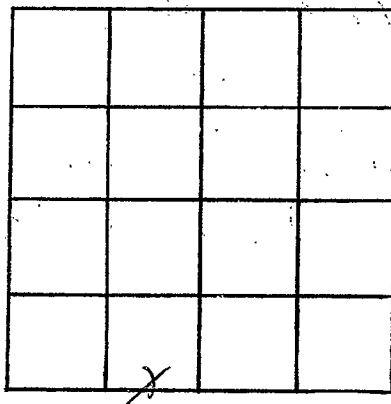

SECTION 23

Please indicate well location X.

ADDITIONAL INFORMATION

If more than one screen, show locations of each on sketch.