

MONROE  
 P 213  
 7-13-79

MISSISSIPPI  
 BOARD OF WATER COMMISSIONERS  
 416 North State Street  
 Jackson, Mississippi 39201

WATER WELL DRILLERS LOG

7-13 1979 date well completed  
 Herman Homan Well & Supply, Inc. P. O. Box 42  
 SHANNON, MISSISSIPPI 38668  
 MONROE county well located

LANDOWNER: Johnny Gibbs  
 ref  
Aberdeen MS (mailing address)  
 WELL LOCATION:  
 sec. 27 T. 15 N. R. 2 E.  
3 miles S of Aberdeen  
 (distance) (direction) (nearest town)

description of formations encountered	from	to
<u>sand</u>	<u>0</u>	<u>9.5</u>
<u>clay</u>	<u>9.5</u>	<u>10.5</u>
<u>sand</u>	<u>10.5</u>	<u>19.0</u>
<u>Rock</u>	<u>24.0</u>	

WELL PURPOSE: Home  
 (home, irrigation, municipal, industrial)

WELL COMPLETION DATA:

(1) diameter (inches) 4"

(2) total depth (feet) 240'

(3) static water level (feet) 123' below top of ground.

(4) casing steel, 10.5' (material) (depth)  
4" (size) if telescope see back.

(5) screen no (length) (depth to top)  
 (size) (material)

(6) pump 4 1/2 (HP) 5 (yield gpm)  
electric (type power)

(7) electric log no (yes or no)  
 (organization running log)

(8) how well bottom plugged open

Miss. Board of Water Comm.


AUG 13 1979

DRILLERS REMARKS:

RECEIVED

If well telescopes please sketch and show depths.

GROUND LEVEL

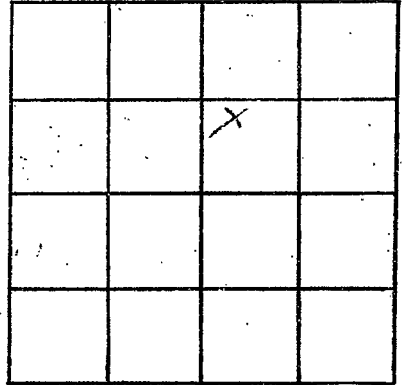

SECTION 27

Please indicate well location X.

ADDITIONAL INFORMATION

If more than one screen, show locations of each on sketch.