

Monroe
P 2014
10-20-79

MISSISSIPPI
BOARD OF WATER COMMISSIONERS
416 North State Street
Jackson, Mississippi 39201

WATER WELL DRILLERS LOG

12/22 1979 Herman Homan Well & Supply, Inc. Monroe
date well completed firm name county well located

LANDOWNER:
DAVID DAWK
Rt 2 West Point, MS
(mailing address)

description of formations encountered	from	to
surface sand		
clay	0	38
blue clay	38	100
sand	100	220
bottom	220	

WELL LOCATION:
sec. 13-T-16 R-2 E
8 miles S of Aberdeen
(distance) (direction) (nearest town)

WELL PURPOSE:
Home
(home, irrigation, municipal, industrial)

- WELL COMPLETION DATA:
- (1) diameter (inches) 4"
 - (2) total depth (feet) 220'
 - (3) static water level (feet) 79' below top of ground.
 - (4) casing steel, 4" ID, 4' depth
4" if telescope see back.
(size)
 - (5) screen 20' (length) (depth to top)
(size) (material)
 - (6) pump 1/2 HP, 5 (yield gpm)
clark (type power)
 - (7) electric log no (yes or no)
(organization running log)
 - (8) how well bottom plugged open

DRILLERS REMARKS:


DEPT. OF NATURAL RESOURCES
BUREAU OF LAND & WATER

DEC - 7 1979

RECEIVED

If well telescopes please sketch and show depths.

GROUND LEVEL

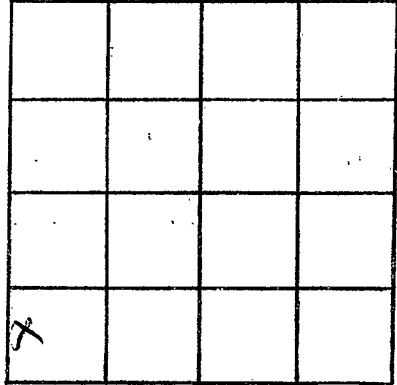

SECTION 3

Please indicate well location X.

ADDITIONAL INFORMATION

Lined area for additional information.

If more than one screen, show locations of each on sketch.