

MISSISSIPPI DEPARTMENT OF NATURAL RESOURCES

Bureau of Land and Water Resources

Southport Mall

P.O. Box 10631

Jackson, Mississippi 39209

WATER WELL DRILLERS LOG

Monroe
P 2015
8/12/80

8/12 1980 Clardy Well Drilling Monroe
 date well completed firm name county well located

LANDOWNER: Wesley Jordan
Aberdeen, Miss.
 (mailing address)

WELL LOCATION:
 sec. 35 T. 15 N. R. 7 E.
6 miles S of Aberdeen
 (distance) (direction) (nearest town)

WELL PURPOSE: home
 (home, irrigation, municipal, industrial)

- WELL COMPLETION DATA:
- (1) diameter (inches) 4"
 - (2) total depth (feet) 280'
 - (3) static water level (feet) 70' below above-top of ground.
 - (4) casing PVC 200'
 (material) (depth)
 _____ if telescope see back.
 (size)
 - (5) screen _____
 (length) (depth to top)

 (size) (material)
 - (6) pump 3/4 800 per hr.
 (HP) (yield gpm)

 (type power)
 - (7) electric log No
 (yes or no)

 (organization running log)
 - (8) how well bottom plugged open

description of formations encountered	from	to
Clay	0	50
Soft shandy blue clay	50	75
blue clay	75	121
rock	121	
Sandy blue clay	121	177
hard rock	177	
blue clay	177	218
sand & rocks	218	265
blue clay	265	280

DRILLERS REMARKS: _____


DEPT. OF NATURAL RESOURCES
 BUREAU OF LAND & WATER RESOURCES

SEP 8 - 1980

RECEIVED

If well telescopes please sketch and show depths.

GROUND LEVEL

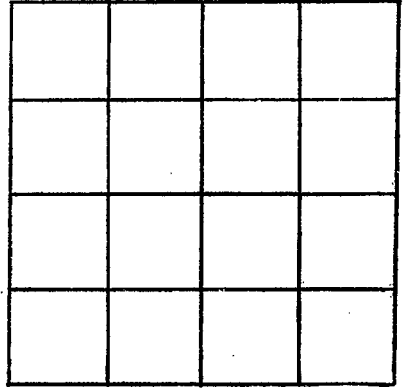

SECTION _____

Please indicate well location X.

ADDITIONAL INFORMATION

If more than one screen, show locations of each on sketch.