

MISSISSIPPI DEPARTMENT OF NATURAL RESOURCES

Bureau of Land and Water Resources

Southport Mall

P.O. Box 10631

Jackson, Mississippi 39209

WATER WELL DRILLERS LOG

<u>MONROE</u>
<u>P 2016</u>
<u>10-30-80</u>

10-30 1980 Clardy Well Drilling Monroe
 date well completed firm name county well located

LANDOWNER: Don Self
New Hamilton, Miss

description of formations encountered	from	to
<u>Sand & gravel</u>	<u>14</u>	<u>30</u>
<u>blue clay rock</u>	<u>30</u>	<u>107</u>
<u>Sand</u>	<u>107</u>	<u>110</u>
<u>brown clay</u>	<u>110</u>	<u>150</u>
<u>Sand</u>	<u>150</u>	<u>160</u>

(mailing address)

WELL LOCATION:

sec. 18 T. 16 N. R. 19 E. 7
4 1/2 miles SW of New Hamilton
 (distance) (direction) (nearest town)

WELL PURPOSE: home
 (home, irrigation, municipal, industrial)

WELL COMPLETION DATA:

- (1) diameter (inches) 4"
- (2) total depth (feet) 163
- (3) static water level (feet) 32 ~~below~~ above top of ground.
- (4) casing PVC, 84
 (material) (depth)
4"
 (size) if telescope see back.
- (5) screen _____
 (length) (depth to top)
 (size) (material)
- (6) pump 1/2 400 hr.
 (HP) (yield gpm)
 (type power)
- (7) electric log _____
 (yes or no)
 (organization running log)
- (8) how well bottom plugged open

DRILLERS REMARKS:


DEPT. OF NATURAL RESOURCES
 BUREAU OF LAND & WATER RESOURCES

NOV - 6 1980

RECEIVED

If well telescopes please sketch and show depths.

GROUND LEVEL

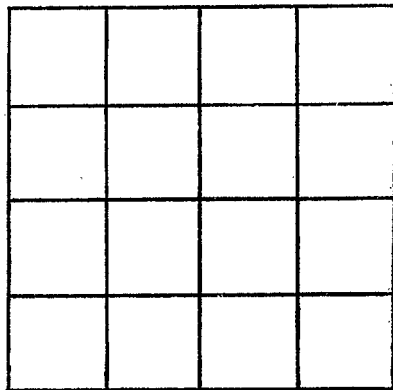

SECTION _____

Please indicate well location X.

ADDITIONAL INFORMATION

A series of horizontal lines for providing additional information, starting below the 'ADDITIONAL INFORMATION' header and extending to the bottom of the page.

If more than one screen, show locations of each on sketch.