

MISSISSIPPI DEPARTMENT OF NATURAL RESOURCES

Bureau of Land and Water Resources

Southport Mall

P.O. Box 10631

Jackson, Mississippi 39209

WATER WELL DRILLERS LOG

Monroe
P 2017
10-12-81

10-12-81 date well completed 1981 Leeper Drilling firm name Monroe county well located

| LANDOWNER: | description of formations encountered | from | to |
|--|---------------------------------------|------|-----|
| DAVID SARGENT DARRETT RD ABERDEEN (mailing address) | | | |
| WELL LOCATION: sec. <u>26</u> T. <u>15</u> N. R. <u>7</u> E <u>6</u> miles <u>SE</u> of <u>ABERDEEN</u> (distance) (direction) (nearest town) | TOP clay | 0 | 30 |
| WELL PURPOSE: <u>Home</u> (home, irrigation, municipal, industrial) | GREEN SAND | 30 | 130 |
| WELL COMPLETION DATA: (1) diameter (inches) <u>4</u> | clay | 130 | 148 |
| (2) total depth (feet) <u>162</u> | white sand | 148 | 162 |
| (3) static water level (feet) <u>100</u> below top of ground | | | |
| (4) casing <u>PVC</u> <u>152</u> (material) (depth) | | | |
| <u>4</u> if telescope see back. (size) | | | |
| (5) screen <u>10</u> <u>152</u> (length) (depth to top) | | | |
| <u>4</u> <u>PVC</u> (size) (material) | | | |
| (6) pump <u>3/4</u> <u>10</u> (HP) (yield gpm) | | | |
| <u>electric</u> (type power) | | | |
| (7) electric log <u>NO</u> (yes or no) | | | |
| (organization running log) | | | |
| (8) how well bottom plugged <u>CAP</u> | | | |
| DRILLERS REMARKS: | | | |


DEPT. OF NATURAL RESOURCES
 BUREAU OF LAND & WATER RESOURCES

OCT 15 1981

RECEIVED

If well telescopes please sketch and show depths.

GROUND LEVEL

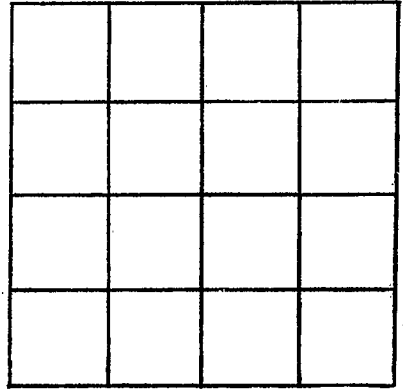

SECTION _____

Please indicate well location X.

ADDITIONAL INFORMATION

RECEIVED
81 OCT 15 4 8 : 50

If more than one screen, show locations of each on sketch.