

MISSISSIPPI DEPARTMENT OF NATURAL RESOURCES

Bureau of Land and Water Resources

Southport Mall

P.O. Box 10631

Jackson, Mississippi 39209

WATER WELL DRILLERS LOG

**MONROE**  
P 2019

9-4-84 19 Cloudy Well Drilling Monroe  
date well completed firm name county well located

LANDOWNER: Lay Gilroath  
Rt 4  
Aberdeen, MS  
(mailing address)

WELL LOCATION:  
sec. 35 T. 15 N R. 7E  
6 miles S of Aberdeen  
(distance) (direction) (nearest town)

WELL PURPOSE: home  
(home, irrigation, municipal, industrial)

WELL COMPLETION DATA:

(1) diameter (inches) 4"

(2) total depth (feet) 281'

(3) static water level (feet) 97' below top of ground.

(4) casing PVC 184'  
(material) (depth)  
4"  
(size) if telescope see back.

(5) screen 40'  
(length) (depth to top)  
2" PVC  
(size) (material)

(6) pump 3/4 900 gph.  
(HP) (yield gpm)

elec.  
(type power)

(7) electric log no  
(yes or no)

(organization running log)

(8) how well bottom plugged

description of formations encountered	from	to
<u>brown clay</u>	<u>0</u>	<u>14</u>
<u>good thin clay</u>	<u>14</u>	<u>24</u>
<u>sandy thin clay</u>	<u>24</u>	<u>78 1/2</u>
<u>rock</u>	<u>78 1/2</u>	<u>80</u>
<u>sandy clay</u>	<u>80</u>	<u>135 1/2</u>
<u>rock</u>	<u>135 1/2</u>	<u>137</u>
<u>sandy clay</u>	<u>137</u>	<u>171</u>
<u>good clay</u>	<u>171</u>	<u>185</u>
<u>sandy clay</u>	<u>185</u>	<u>228</u>
<u>sand</u>	<u>228</u>	<u>234</u>
<u>rock (2")</u>	<u>234</u>	
<u>sand</u>	<u>234</u>	<u>241</u>
<u>rock (2")</u>	<u>241</u>	
<u>sand</u>	<u>241</u>	<u>280</u>
<u>sandy clay</u>	<u>280</u>	<u>281</u>

DRILLERS REMARKS:


DEPT. OF NATURAL RESOURCES  
BUREAU OF LAND & WATER RESOURCES  
OCT 22 1984  
RECEIVED

If well telescopes please sketch and show depths.

GROUND LEVEL

184' - 4"

Spic new 69' 2"

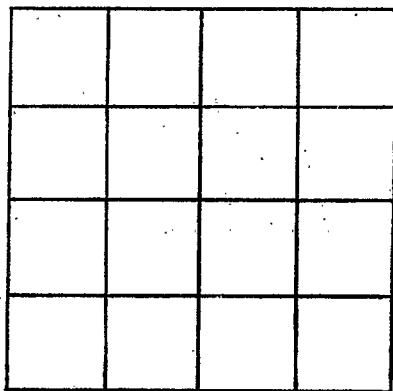

SECTION \_\_\_\_\_

Please indicate well location X.

ADDITIONAL INFORMATION

If more than one screen, show locations of each on sketch.