

MISSISSIPPI DEPARTMENT OF NATURAL RESOURCES

Bureau of Land and Water Resources

Southport Mall

P.O. Box 10631

Jackson, Mississippi 39209

WATER WELL DRILLERS LOG

MONROE
Q P
2020

9-17-84 19 Clardy Well Drilling Monroe
 date well completed firm name county well located

LANDOWNER: Irene Dilbreath
Rt 4
Aberdeen, MS
 (mailing address)

WELL LOCATION:
 sec 35 T. 15 N. R. 7 E
6 miles S of Aberdeen
 (distance) (direction) (nearest town)

WELL PURPOSE: home
 (home, irrigation, municipal, industrial)

WELL COMPLETION DATA:

(1) diameter (inches) 4"

(2) total depth (feet) 281'

(3) static water level (feet) 97' below above top of ground.

(4) casing PVC, 184',
 (material) (depth)
4"
 (size) if telescope see back.

(5) screen 40',
 (length) (depth to top)
2", PVC
 (size) (material)

(6) pump 3/4, 900 gph,
 (HP) (yield gph)
elec
 (type power)

(7) electric log no
 (yes or no)

(organization running log)

description of formations encountered	from	to
brown clay	0	15
rock (2")		
brown clay	15	17
sandy clay	17	35
rock	35	36 1/2
sandy blue clay	36 1/2	73
rock 6"	73	73 1/2
sandy clay	73 1/2	174 1/2
rock	174 1/2	176
clay	176	176 1/2
rock	176 1/2	178
sandy clay	178	190
good clay	190	199 1/2
rock	199 1/2	201
sandy clay	201	240
sand	240	245
sandy clay	245	257
sand	257	280
sandy clay	280	281

(8) how well bottom plugged _____

DRILLERS REMARKS: _____

DEPT. OF NATURAL RESOURCES
 BUREAU OF LAND & WATER RESOURCES


OCT 22 1984
 RECEIVED

If well telescopes please sketch and show depths.

GROUND LEVEL

Screen 19' - 2" 184' 4"

If more than one screen, show locations of each on sketch.

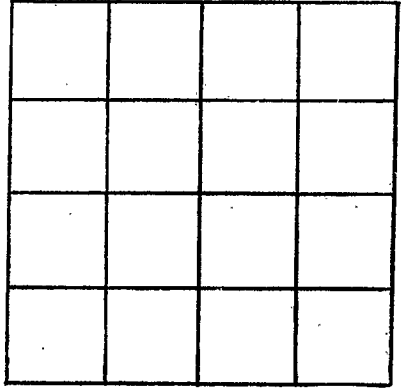

SECTION _____

Please indicate well location X.

ADDITIONAL INFORMATION

184'

19' - 2"