

MISSISSIPPI DEPARTMENT OF NATURAL RESOURCES

Bureau of Land and Water Resources

Southport Mall

P.O. Box 10631

Jackson, Mississippi 39209

WATER WELL DRILLERS LOG

MONROE
P 2021

9-21-84 date well completed
Clardy Well Drilling Monroe firm name
Monroe county well located

LANDOWNER: W. R. Hill
Aberdeen, MS
(mailing address)

WELL LOCATION:
sec. 35 T. 15 N R. 7 E
6 miles S of Aberdeen
(distance) (direction) (nearest town)

WELL PURPOSE: Home
(home, irrigation, municipal, industrial)

WELL COMPLETION DATA:

(1) diameter (inches) 4"

(2) total depth (feet) 322'

(3) static water level (feet) 115 below above top of ground.

(4) casing PVC 193
(material) (depth)
(size) If telescope see back.

(5) screen 40'
(length) (depth to top)
2" PVC
(size) (material)

(6) pump 3/4 700 gph
(HP) (yield gpm)
elec.
(type power)

(7) electric log no
(yes or no)
(organization running log)

(8) how well bottom plugged _____

description of formations encountered	from	to
brown clay	0	22 1/2
rock	22 1/2	23 1/2
red clay	23 1/2	25
sandy blue clay	35	110 1/2
rock	110 1/2	112
sandy clay	112	122
hard clay	122	133 1/2
rock	133 1/2	135
hard clay	135	139
sandy clay	139	189
good clay	189	197
sandy clay	197	216
rock	216	216 1/2
sandy clay	216 1/2	220
sand	220	238
sandy clay	238	248
good clay	248	255 1/2
rock	255 1/2	256 1/2
sand	256 1/2	257
rock	257	257 1/2
sandy clay	257 1/2	263
good clay	263	276
sand	276	278
sandy clay	278	280
sand	280	284
sandy clay	284	293
sand	293	298
sandy clay	298	300
sand	300	301
sandy clay	301	315 1/2
rock	315 1/2	316
sand	316	322

BUREAU OF NATURAL RESOURCES
LAND & WATER RESOURCES

OCT 22 1984

RECEIVED


DRILLERS REMARKS: _____

If well telescopes please sketch and show depths.

GROUND LEVEL

Hand pump
28 screen
79'-2"
193'

2 shale
catcher
1 packer

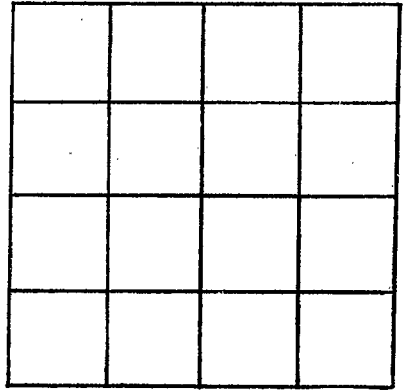

SECTION _____

Please indicate well location X.

ADDITIONAL INFORMATION

If more than one screen,
show locations of each on sketch.