

MONROE
P 2023

MISSISSIPPI DEPARTMENT OF NATURAL RESOURCES
 Bureau of Land and Water Resources
 Southport Mall
 P.O. Box 10631
 Jackson, Mississippi 39209
WATER WELL DRILLERS LOG

Sept 1986 Leeper Drilling Monroe
 date well completed firm name county well located

LANDOWNER: DICK STHALS
Darcouette Road
ABERDEEN MS.
 (mailing address)

description of formations encountered	from	to
<u>TOP CLAY</u>	<u>0</u>	<u>20</u>
<u>BLUE CLAY</u>	<u>20</u>	<u>30</u>
<u>GREEN SAND</u>	<u>30</u>	<u>120</u>
<u>Bentwite</u>	<u>120</u>	<u>128</u>
<u>GREEN SAND</u>	<u>128</u>	<u>140</u>
<u>White Sand</u>	<u>140</u>	<u>185</u>

WELL LOCATION:
 sec. 26-T. 15 N R. 7 E
S miles S of ABERDEEN
 (distance) (direction) (nearest town)

WELL PURPOSE: HOME
 (home, irrigation, municipal, industrial)

- WELL COMPLETION DATA:
- diameter (inches) 4"
 - total depth (feet) 185
 - static water level (feet) 120 ^{below}/_{above} top of ground.
 - casing PVC 175'
 (material) (depth)
4"
 (size) if telescope see back.
 - screen 10' 175'
 (length) (depth to top)
4" PVC
 (size) (material)
 - pump 3/4 10
 (HP) (yield gpm)
ELEC
 (type power)
 - electric log NO
 (yes or no)

(organization running log)


(8) how well bottom plugged BACK-
WASH VALUE

DRILLERS REMARKS:

DEPARTMENT OF NATURAL RESOURCES
 STATE OF MISSISSIPPI
 SEP 10 1986
 Department of Natural Resources
 Bureau of Land & Water Resources

If well telescopes please sketch and show depths.

GROUND LEVEL

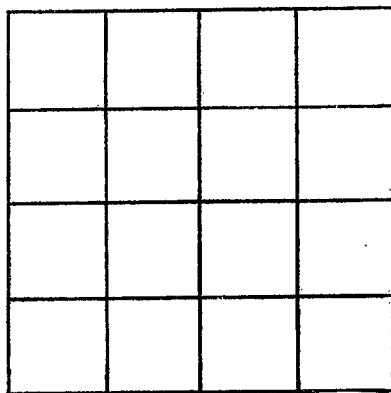

SECTION _____

Please indicate well location X.

ADDITIONAL INFORMATION

If more than one screen,
show locations of each on sketch.