

MONROE  
P 2025

MISSISSIPPI  
BOARD OF WATER COMMISSIONERS  
416 North State Street  
Jackson, Mississippi 39201

WATER WELL DRILLERS LOG

Sept 1986 date well completed  
LEEPER Drilling firm name  
Monroe county well located

LANDOWNER: Joe Morgan  
DARCOUETTE Road  
ABERDEEN MS  
(mailing address)

WELL LOCATION:  
sec. 26 T 15 N R 7 E  
S W  
(distance) miles (direction) of (nearest town)

WELL PURPOSE:  
(home, irrigation, municipal, industrial)

WELL COMPLETION DATA:  
(1) diameter (inches) 4"  
(2) total depth (feet) 184'  
(3) static water level (feet) 110' below top of ground.  
(4) casing PVC 174' (material) (depth)  
4" (size) If telescope see back.  
(5) screen 10' 174' (length) (depth to top)  
4" PVC (size) (material)  
(6) pump 3/4 10 (HP) (yield gpm)  
ELEC (type power)  
(7) electric log NO (yes or no)  
(organization running log)

description of formations encountered	from	to
TOP CLAY	0	20
BLUE CLAY	20	60
GREEN Cemented SAND	60	120
Bentonite	120	130
White SAND	130	184


RECEIVED  
NOV 12 1986

Department of Natural Resources  
Bureau of Land & Water Resources

(8) how well bottom plugged  
BACK WASH VALVE  
DRILLERS REMARKS:

If well telescopes please sketch and show depths.

GROUND LEVEL

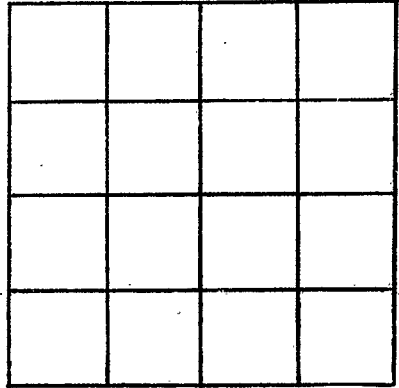

SECTION \_\_\_\_\_

Please indicate well location X.

ADDITIONAL INFORMATION

If more than one screen,  
show locations of each on sketch.