

MISSISSIPPI DEPARTMENT OF NATURAL RESOURCES
Bureau of Land and Water Resources

P.O. Box 10631

Jackson, Mississippi 39209
WATER WELL DRILLERS LOG

COUNTY WELL LOCATED MONROE	
WELL NUMBER P 2028	CODED
DATE WELL COMPLETED 12/17/87	

PERMIT NUMBER
NAME OF DRILLING FIRM L. W. L. Well & Svc. Shannon, MS

NAME & MAILING ADDRESS OF LANDOWNER Linda Murphy Rt. 4 Box 244 Abbeville, MS			
WELL LOCATION:	SEC	TOWNSHIP	RANGE
	26	15	7
		N	W
DISTANCE	DIRECTION	NEAREST TOWN	
4 Miles	S of	Abbeville	
OTHER LANDMARK			
WELL PURPOSE: <input checked="" type="checkbox"/> Irrigation, <input type="checkbox"/> Municipal, <input type="checkbox"/> Industrial, <input type="checkbox"/> Fish Pond, etc.			

PUMP DATA		
PUMP TYPE (Circle One): Submersible , Turbine, Jet, Flowing Well, Other (Describe) _____		
POWER TYPE (Circle One): Electric , Tractor, Diesel, Gasoline, Butane, Other (Describe) 1/2 HP		
Pump Capacity (GPM) 5	No. of Stages 9	Setting Depth 147 FT.
PUMP TEST		
Well yielded _____ GPM with a drawdown of _____ ft. after _____ hours of pumping		

WELL DATA		
Well Depth 180'	Casing Diameter (In.) 4"	Casing Length (Ft.) 180'
Type of Casing PVC	Hole Depth 180'	Depth to Static Water Level
TYPE OF COMPLETION: (Circle One or More): Gravel Packed , Underreamed, Telescoped, Natural Development, Open Hole, Other		
Top of Lap Pipe or Reduction in Casing		
FEET	IF TELESCOPED OR MORE THAN ONE SCREEN: USE BACK PAGE	

LOG DATA	
TYPE OF LOG RUN (Circle One): Not Log Run, Electric, Gamma Ray, Density, Sonic, Neutron, Other (Describe) _____	
Name of Organization Running Log	


SCREEN DATA		
Diameter - Inches 4"	Length - Feet 10'	Slot Size - Inches .016
Screen Type PVC		Depth to Bottom - Feet 180

GEOLOGIC DATA (Office Use Only)			
Surface Elev.	Geologic Unit	Unit Thickness	Depth to Top
Subs. SWL	Date	Analysis	Aquifer Test
Driller's Remarks			

DESCRIPTION OF FORMATIONS ENCOUNTERED	FROM	TO	FORMATIONS (Continued)	
			FROM	TO
			DECEMBER 1987	
			MAY 18 1988	
			Department of Natural Resources Bureau of Land & Water Resources	
			IF MORE SPACE IS NEEDED, USE BACK	

If well telescopes please
sketch and show depths.

GROUND LEVEL

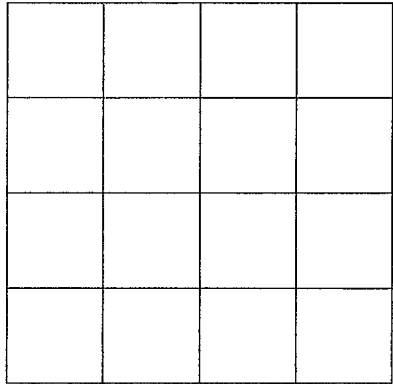

SECTION _____

Please indicate well location X.

ADDITIONAL INFORMATION

If more than one screen,
show location of each on sketch.
