

MISSISSIPPI DEPARTMENT OF NATURAL RESOURCES

Bureau of Land and Water Resources

P.O. Box 10631

Jackson, Mississippi 39209

WATER WELL DRILLERS LOG

COUNTY LOCATED Montee	
WELL NUMBER P 2033	CODED
DATE WELL COMPLETED 8/1/89	

PERMIT NUMBER 0-379
NAME OF DRILLING FIRM Mid South Drilling Co.
Carrollton, AL 35447

NAME & MAILING ADDRESS OF LANDOWNER O. C. Electric (contractor)			
2002 4th Ave. North			
Columbus, MS 39701			
WELL LOCATION:	SEC	TOWNSHIP	RANGE
	14	16	N 7 W
DISTANCE	DIRECTION	NEAREST TOWN	
6 Miles	NE	of Westpoint	
OTHER LANDMARK			
WELL PURPOSE: Home, Irrigation, Municipal, Industrial, Fish Pond, etc. HOME			

PUMP DATA		
PUMP TYPE (Circle One): Submersible, Turbine, Jet, Flowing Well, Other (Describe) _____		
POWER TYPE (Circle One): Electric, Tractor, Diesel, Gasoline, Butane, Other (Describe) _____		
Pump Capacity (GPM)	No. of Stages	Setting Depth FT.
PUMP TEST		
Well yielded _____ GPM with a drawdown of _____ ft. after _____ hours of pumping		

WELL DATA		
Well Depth 310'	Casing Diameter (In.) 4"	Casing Length (Ft.) see back
Type of Casing PVC	Hole Depth 310	Depth to Static Water Level 93
TYPE OF COMPLETION: (Circle One or More): Gravel Packed , Underreamed, Telescoped , Natural Development, Open Hole, Other		
Top of Lap Pipe or Reduction in Casing 230'		
FEET IF TELESCOPED OR MORE THAN ONE SCREEN: USE BACK PAGE		

LOG DATA	
TYPE OF LOG RUN (Circle One): No Log Run, Electric, Gamma Ray, Density, Sonic, Neutron, Other (Describe) _____	
Name of Organization Running Log	


GEOLOGIC DATA (Office Use Only)			
Surface Elev.	Geologic Unit	Unit Thickness	Depth to Top
Subs. SWL	Date	Analysis	Admeter Test

SCREEN DATA		
Diameter - Inches 2	Length - Feet 60	Slot Size - Inches .014
Screen Type PVC		Depth to Bottom - Feet

Driller's Remarks AUG 14 1989
Department of Natural Resources Bureau of Land & Water Resources

DESCRIPTION OF FORMATIONS ENCOUNTERED	FROM	TO	FORMATIONS (Continued)	FROM	TO
clay	0	28	sand w/clays streak	257	264
sand	28	37	sand	264	285
rock	37	38½	sand w/clay streak	285	292
sandy clay	38½	137	sand	292	305
sand	137	158	clay	305	310
clay w/sand streak	158	190			
clay	190	194	rock at 87,110,137		
clay w/sand streak	194	237			
clay	237	239			
sand w/clay streak	239	245			
sand	245	257			
IF MORE SPACE IS NEEDED, USE BACK					

If well telescopes please sketch and show depths.

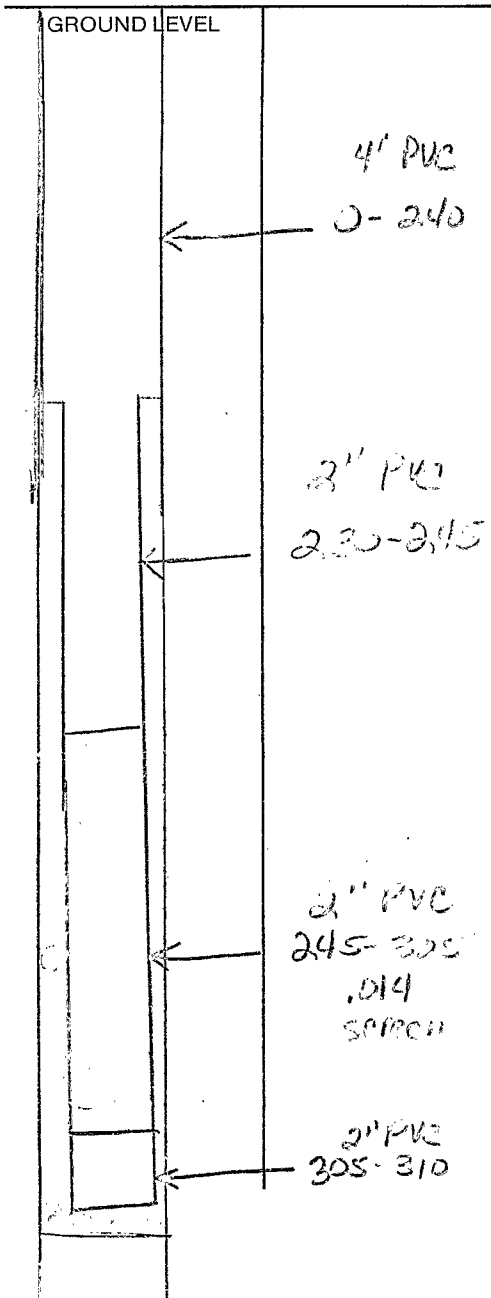

SECTION _____

Please indicate well location X.

ADDITIONAL INFORMATION

If more than one screen, show location of each on sketch.