

MISSISSIPPI DEPARTMENT OF ENVIRONMENTAL QUALITY
Bureau of Land and Water Resources

P. O. Box 10631
Jackson, MS 39289-0631
WATER WELL DRILLERS LOG

COUNTY WELL LOCATED Monroe	
WELL NUMBER 1	CODED
P 2042	
DATE WELL COMPLETED 5/04/99	

PERMIT NUMBER
NAME OF DRILLING FIRM Herndon Well & Supply
Shannon, MS

NAME & MAILING ADDRESS OF LANDOWNER Earl Sanders			
10266 Hwy 45 Alt			
Prairie, MS 39756			
WELL LOCATION:	SEC	TOWNSHIP	RANGE
	2	16 S	7 E
DISTANCE	DIRECTION	NEAREST TOWN	
7 Miles	South	Aberdeen	
OTHER LANDMARK			
WELL PURPOSE: Home, Irrigation, Municipal, Industrial, Fish Pond, etc. Home			

PUMP DATA		
PUMP TYPE (Circle One): Customer's pump		
<input checked="" type="radio"/> Submersible	<input type="radio"/> Turbine	<input type="radio"/> Jet
Other (Describe) _____		
POWER TYPE (Circle One):		
<input type="radio"/> Electric	<input type="radio"/> Tractor	<input type="radio"/> Diesel
<input type="radio"/> Gasoline	<input type="radio"/> Butane	
Other (Describe) _____ H/P 3/4		
Pump Capacity (GPM)	No. of Stages	Setting Depth
		FT.
PUMP TEST		
Well yielded _____ GPM with		
a drawdown of _____ ft.		
after _____ hours of pumping		

WELL DATA		
Well Depth 400'	Casing Diameter (In.) 5"	Casing Length (Ft.) 31'
Type of Casing Steel	Hole Depth 400'	Depth to Static Water Level 123'
TYPE OF COMPLETION: (Circle One or More):		
<input checked="" type="radio"/> Gravel Packed	<input type="radio"/> Underreamed	<input type="radio"/> Telescoped
<input type="radio"/> Natural Development	<input type="radio"/> Open Hole	<input type="radio"/> Other
(Describe) _____		
Top of Lap Pipe or Reduction in Casing		
FEET	IF TELESCOPED OR MORE THAN ONE SCREEN: USE BACK PAGE	

LOG DATA	
TYPE OF LOG RUN (Circle One): No Log Run	
<input type="radio"/> Electric	<input type="radio"/> Gamma Ray
<input type="radio"/> Density	<input type="radio"/> Sonic
<input type="radio"/> Neutron	<input type="radio"/> Other (Describe) _____
Name of Organization Running Log	

SCREEN DATA		
Diameter - Inches N/A	Length - Feet	Slot Size - Inches
Screen Type	Depth to Bottom - Feet	

GEOLOGIC DATA (Office Use Only)			
Surface Elev.	Geologic Unit	Unit Thickness	Depth to Top
Subs. SWL	Date	Analysis	Aquifer Test
Driller's Remarks			


DESCRIPTION OF FORMATIONS ENCOUNTERED	FROM	TO	FORMATIONS (Continued)	FROM	TO
Brown Clay	0	20			
Blue	20	90			
Sandy Clay	90	275			
Sand	275	300			
Blue Clay	300	320			
Sandy Strkld Clay	320	400			

IF MORE SPACE IS NEEDED, USE BACK

Bureau of Environmental Quality
Office of Land & Water Resources

If well telescopes please
sketch and show depths.

GROUND LEVEL

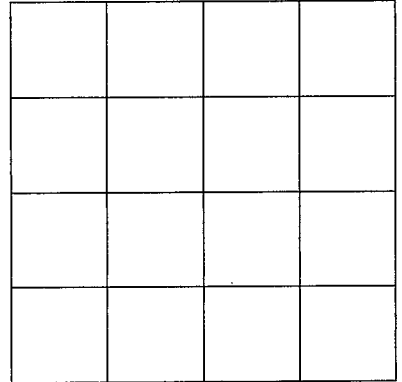

SECTION _____

Please indicate well location X.

ADDITIONAL INFORMATION

If more than one screen,
show location of each on sketch.