

Monroe
6-66

WATER WELL DRILLERS LOG

Monroe

Date: June, 1966, Driller: W. B. Clardy County: Monroe
(Name)

(1) Owner of Land: Marvin Taylor
(Name)
Highway 45 N.
(Address)

(2) Location: 1/4, 1/4, Sec 3? T. R.
10 miles N of Colo.
(distance) (direction) (Nearest Town)

(3) Topography: Flat
(Hilly) (Flat) (Level)

(4) Purpose of Well: domestic
(Domestic Irrigation
Municipal, Industrial, Other)

Description & Color of Materials Sand, Clay, Red Clay, Shell, etc.	Thick- ness Feet	Depth Feet
<u>Sand + gravel</u>	<u>8'</u>	<u>26'</u>
<u>Blue Clay (sandy)</u>	<u>28'</u>	<u>54'</u>
<u>solid blue clay</u>	<u>59'</u>	<u>113'</u>
<u>Sand</u>	<u>75'</u>	<u>120'</u>

Information upon completion of well:

(1) Diameter 4 inches.

(2) Total Depth 120 feet.

(3) Water level 30 feet below top of ground.

(4) Cased to 63', Size 4"


(5) Screen: Size _____, Length _____

(6) Were any formations sealed against pollution?
_____ yes, _____ no.

If YES depth of formation _____

Why _____

Drillers Remarks: _____

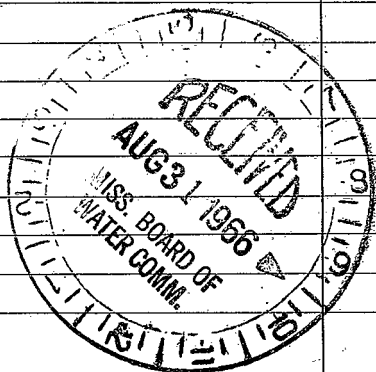

(Use Back Side)

Well No.

