

CODED

MONROE
Q44
6-21-69

MISSISSIPPI
BOARD OF WATER COMMISSION
416 North State Street
Jackson, Mississippi 39201

CODED

WATER WELL DRILLERS LOG

6-21 1969 W.J. REEVES & SON MONROE
date well completed firm name county well located

LANDOWNER: TRAVIS GORDEN
HAMILTON

description of formations encountered	from	to
RED CLAY	0	23
" SAND	23	68
BLUE CLAY	68	70

(mailing address)

WELL LOCATION:
sec 10 T. 15 S. R. 18 W.
8 miles SE of ABERDEEN
(distance) (direction) (nearest town)

WELL PURPOSE: HOME
(home, irrigation, municipal, industrial)

WELL COMPLETION DATA:

- (1) diameter (inches) 4
- (2) total depth (feet) 70
- (3) static water level (feet) 35 below top of ground.
- (4) casing PVC, 50 (depth), 4 (size) if telescope see back.
- (5) screen 20 (length), 50 (depth to top), 4 (size), PVC (material)
- (6) pump 1 (HP), 6 (yield gpm), ELECT (type power)
- (7) electric log NO (yes or no)
- (organization running log)
- (8) how well bottom plugged SAND

CODED


AUG 18 1969

MISS. BD. OF WATER

DRILLERS REMARKS:

If well telescopes please sketch and show depths.

GROUND LEVEL

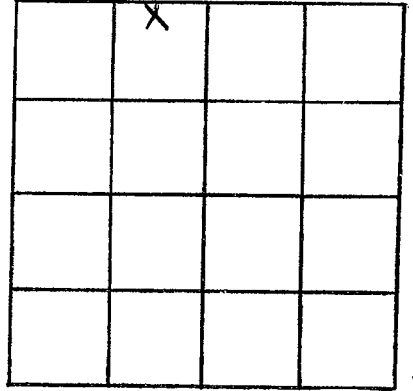

SECTION 10

Please indicate well location X.

ADDITIONAL INFORMATION

If more than one screen,
show locations of each on sketch.