

MONROE
Q 48
9-26-70

MISSISSIPPI
BOARD OF WATER COMMISSIONERS
416 North State Street
Jackson, Mississippi 39201

CODED

WATER WELL DRILLERS LOG

9-26 1970 W. J. REEVES & SON MONROE
date well completed firm name county well located

LANDOWNER: J. B. MARKHAM

description of formations encountered	from	to
RED CLAY	0	20
RED SANDY CLAY	20	72
RED CLAY	72	88
1" SAND	88	124
BLUE CLAY	124	127

RT. 2
HAMILTON
(mailing address)

WELL LOCATION:
sec. 3 T. 15 S. R. 18 E.
8 miles E of ABERDEEN
(distance) (direction) (nearest town)

WELL PURPOSE:
(home, irrigation, municipal, industrial)

WELL COMPLETION DATA:

- (1) diameter (inches) 4
- (2) total depth (feet) 127
- (3) static water level (feet) 50 below above top of ground:
- (4) casing PVC 107
(material) (depth)
4 if telescope see back.
(size)
- (5) screen 20 107
(length) (depth to top)
4 PVC
(size) (material)
- (6) pump 1/2 10
(HP) (yield gpm)
ELECT
(type power)
- (7) electric log No
(yes or no)

(organization running log)
- (8) how well bottom plugged SAND

CODED


NOV 25 1970

DRILLERS REMARKS:

MISS. BD. OF
WATER COMM.

If well telescopes please sketch and show depths.

GROUND LEVEL

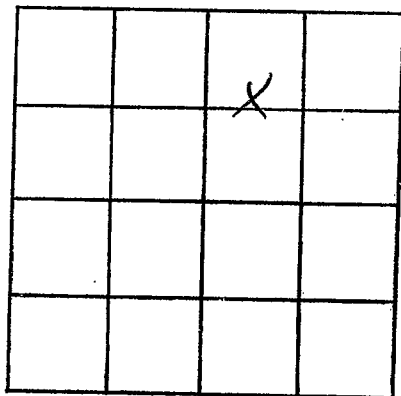

SECTION 3

Please indicate well location X.

ADDITIONAL INFORMATION

If more than one screen,
show locations of each on sketch.