

MONROE
Q-49

Q-30

WATER WELL DRILLERS LOG

CODED

Date: 3-22- 19 62, Driller: Layne-Central Co. County _____

MS-GW-00269

(Name)

(1) Owner of Land: American Potash Co.
(Name)
Hamilton, Mississippi
(Address)

(2) Location: 1/4, 1/4, Sec. T R,
_____ miles _____ of _____
(distance) (direction) (Nearest Town)

(3) Topography: _____
(Hilly) (Flat) (Level)

(4) Purpose of Well: Industrial
(Domestic Irrigation
Municipal, Industrial, Other)


Description & Color of Materials Sand, Clay, Red Clay, Shell, etc.	Thick- ness Feet	Depth Feet
clay	12	0
sand-gravel	11	23
blue shale	19	42
blue clay	48	90
sandy clay	45	135
clay	68	203
sandy shale	47	250
sand	58	308
tough clay	38	346
pk sand-gravel	17	363
pk sand gravel	23	386
pk sand "	24	410
pk sand "	22	432
pk sand "	12	444
clay	21	465
sandy clay	43	508
tough clay	103	611
rock	2	613
sandy clay	5	618
sand	19	637
hard sandy formation	19	656
rock	4	660
hard formation	18	678
hard formation-shale	455	1133
limestone		

Information upon completion of well:

- (1) Diameter 16" inches.
- (2) Total Depth 440' feet.
- (3) Water Level 27' feet below top of ground.
- (4) Cased to 382', Size 16"
- (5) Screen: Size 10", Length 45'
- (6) Were any formations sealed against pollution?
x yes, _____ no.

If YES depth of formation 382'
Why Required

Drillers Remarks:

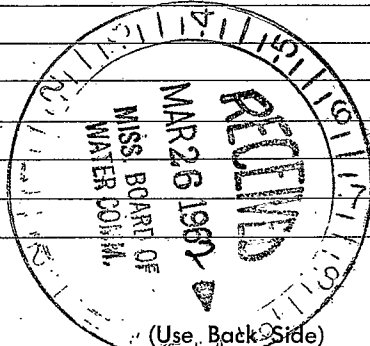

Well No.

(+)

1947

1947