

Q-50
7-8-64

WATER WELL DRILLERS LOG

CODED

Date: 7-8-1964, Driller: Layne-Central Co. County Monroe

MS-GW 00270

(Name)

(1) Owner of Land: American Potash Co.
(Name)

Hamilton, Mississippi

(Address)

(2) Location: 1/4, 1/4, Sec. T R

miles of
(distance) (direction) (Nearest Town)

(3) Topography:

(Hilly) (Flat) (Level)

(4) Purpose of Well: Industrial

(Domestic Irrigation
Municipal, Industrial, Other)

Description & Color of Materials Sand, Clay, Red Clay, Shell, etc.	Thick- ness Feet	Depth Feet
clay	0-10	
sand & gravel	10-26	
hard clay & sand st.	26-100	
hard clay-boulders	100-209	
sand & gravel	209-259	
fine sand	259-296	
clay	296-322	
sand & gravel	322-403	
403 gumbo	403-407	

Information upon completion of well:

(1) Diameter 16 inches.

(2) Total Depth 403 feet.

(3) Water Level 47' feet below top of ground.

(4) Cased to 352', Size 10"

(5) Screen: Size 10", Length 45'

(6) Were any formations sealed against pollution?


X yes, no.

If YES depth of formation 352'

Why required

Drillers Remarks:

CODED

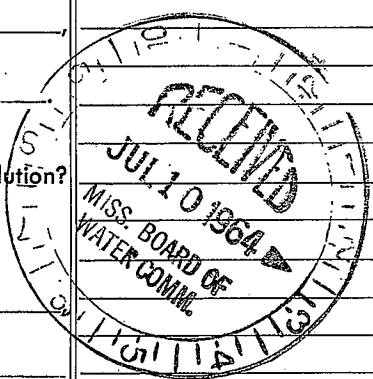

(Use Back Side)

Well No.

①

1944

1944