

MONROE

MISSISSIPPI BOARD OF WATER COMMISSIONERS

Q 51

CODED

WATER WELL DRILLERS LOG

Herndon Well & Supply Co.

Date: 12/31, 1960, Driller: SHANNON, MISS. County: Monroe

(Name)

(1) Owner of Land: Black Building Supply (Name)

Description & Color of Materials Sand, Clay, Red Clay, Shell, etc.

Thick-ness Feet

Depth Feet

Hamilton, Miss. (Contractor) (Address)

sand & clay

50

(2) Location: SW SE SE 1/4, Sec. 27 T15R10W

Blue Rock

14.0

0 miles (distance), of Hamilton (Nearest Town)

sand

245

(3) Topography: level (Hilly) (Flat) (Level)

Bottom

3

(4) Purpose of Well: Community Center (Domestic Irrigation Municipal, Industrial, Other)

Information upon completion of well:

(1) Diameter 4 inches.

(2) Total Depth 245 feet.

(3) Water Level 15 feet below top of ground.

(4) Cased to 245, Size 38' x 4"

(5) Screen: Size 2", Length 20'

(6) Were any formations sealed against pollution?


yes, no.

If YES depth of formation 50'

Why: Sustain & sand

Drillers Remarks:

CODED

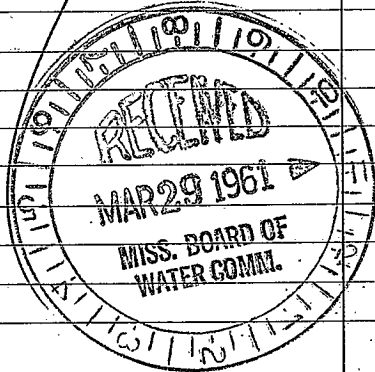

(Use Back Side)

Well No.

