

MISSISSIPPI
BOARD OF WATER COMMISSIONERS
416 North State Street
Jackson, Mississippi 39201

CODED

WATER WELL DRILLERS LOG

1-25 1967 W.J. REEVES & SON MONROE
date well completed firm name county well located

LANDOWNER: <u>DELMER HOLLOWAY</u>	description of formations encountered	from	to
HAMILTON, Miss. (mailing address)	RED CLAY	0	16
	RED SAND & GRAVEL	16	30
	BLUE CLAY	30	38
	" SAND	38	55
	" CLAY	55	56

WELL LOCATION:


33 sec 15 T. 15 S. R. 18 W.
1 miles SE of HAMILTON
(distance) (direction) (nearest town)

WELL PURPOSE:
(home, irrigation, municipal, industrial)

WELL COMPLETION DATA:

- (1) diameter (inches) 4
- (2) total depth (feet) 56
- (3) static water level (feet) 12 below top of ground.
- (4) casing PVC, 56' (material) (depth)
(size) if telescope see back.
- (5) screen 10', 44' (length) (depth to top)
4, PVC (size) (material)
- (6) pump 1/2 (HP) 6 (yield gpm)
ELECT. (type power)
- (7) electric log NO (yes or no)
(organization running log)
- (8) how well bottom plugged SAND

CODED

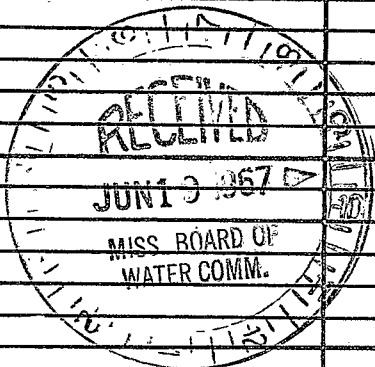


DRILLERS REMARKS:

8" DRILL HOLE
GRAVEL PACKED

If well telescopes please sketch and show depths.

GROUND LEVEL

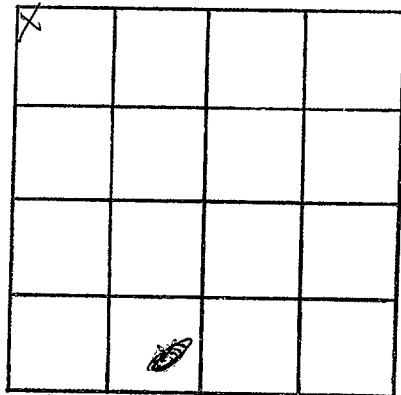

SECTION 28

Please indicate well location X.

ADDITIONAL INFORMATION

If more than one screen, show locations of each on sketch.