

Q 2024

Q 54

10-7-60

WATER WELL DRILLERS LOG

CODED

Date: 10-7, 1960, Driller: W.J. REEVES & SON County MONROE

(Name)

71, 23, 26, 29, 30-32, 35, 36, 39

(1) Owner of Land: ROY TUCKER (Name)

HAMILTON, MISS. (Address)

(2) Location: SE 1/4 NW 1/4, Sec. 2, 10, 17, 15, 18, 19, 20

1/4 miles N of HAMILTON, (distance) (direction) (Nearest Town)

(3) Topography: LEVEL (Hilly) (Flat) (Level)

(4) Purpose of Well: POULTRY (Domestic Irrigation, Municipal, Industrial, Other)

| Description & Color of Materials Sand, Clay, Red Clay, Shell, etc. | Thick- ness Feet | Depth Feet |
|---|------------------------|---------------|
| CLAY | 12 | 0 |
| WHITE SAND + CLAY | 23 | 12 |
| CLAY + SAND STRKS. | 55 | 35 |

CODED

Information upon completion of well:

(1) Diameter 4 inches.

(2) Total Depth 90 feet.

(3) Water Level 6 feet below top of ground.

(4) Cased to 37 1/2', Size 4"

(5) Screen: Size, Length


(6) Were any formations sealed against pollution?

yes, no.

If YES depth of formation

Why

Drillers Remarks:

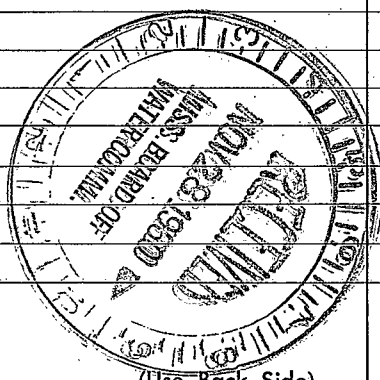

Well No.

1. The first part of the document is a list of names and addresses.

2. The second part of the document is a list of names and addresses.

3. The third part of the document is a list of names and addresses.

4. The fourth part of the document is a list of names and addresses.

5. The fifth part of the document is a list of names and addresses.

6. The sixth part of the document is a list of names and addresses.

7. The seventh part of the document is a list of names and addresses.