

MONROE

Q59

MISSISSIPPI BOARD OF WATER COMMISSIONERS

CODED

4-27-66

WATER WELL DRILLERS LOG

Date: 4-27, 1966 Driller: J.C. REEVES County MONROE

(When well drilled)

(Name)

(Where well is located)

778-5-10 784 1-2-2

(1) Owner of Land:	Description & Color of Materials Sand, Clay, Red Clay, Shell, etc.	Thick- ness Feet	Depth Feet
<u>SIDNEY SANDERS</u> (Name)	<u>RED CLAY</u>	<u>16</u>	
<u>HAMILTON</u> (Address)	<u>SAND & GRAVEL</u>	<u>2</u>	<u>16</u>
(2) Location: <u>NE 1/4, SE 1/4, Sec. 16 T16 R18,</u>	<u>RED SAND</u>	<u>16</u>	<u>18</u>
<u>4</u> miles <u>S</u> of <u>HAMILTON</u> (distance) (direction) (Nearest Town)			
(3) Topography: <u>HILLY</u> (Hilly) (Flat) (Level)			
(4) Purpose of Well: <u>DOMESTIC</u> (Domestic Irrigation Municipal, Industrial, Other)			

Information upon completion of well:

CODED

(1) Diameter 4 inches.

(2) Total Depth 34 feet.

(3) Water Level 22 feet below top of ground.

(4) Cased to 26', Size 4" PVC.

(5) Screen: Size 1/4", Length 8'.

(6) Were any formations sealed against pollution?
 yes, no.

If YES depth of formation _____


Why _____

Drillers Remarks:

Yield in gpm: 12 - AIR

Size pump: 1/2 H.P. JET

Type power: ELECTRIC

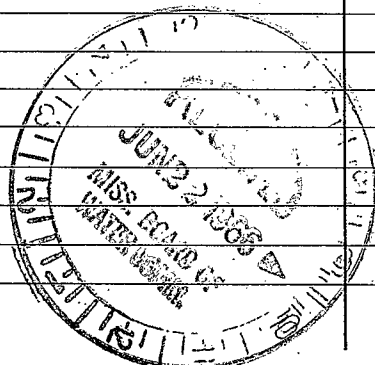

[The page contains extremely faint and illegible text, likely bleed-through from the reverse side of the document. The text is too light to transcribe accurately.]