

MONROE

Q 62

9-23-72

MISSISSIPPI BOARD OF WATER COMMISSIONERS 416 North State Street Jackson, Mississippi 39201

CODE

WATER WELL DRILLERS LOG

9-23

1972

W J REEVES, SON

MONROE

date well completed

firm name

county well located

LANDOWNER: BILL CRACE

HAMILTON

(mailing address)

WELL LOCATION:

sec. 6 T 15 S

R. 18 E

3 miles NO. of HAMILTON (distance) (direction) (nearest town)

WELL PURPOSE: HOME (home, irrigation, municipal, industrial)

WELL COMPLETION DATA:

- (1) diameter (inches) 4
(2) total depth (feet) 100
(3) static water level (feet) 11 below top of ground.
(4) casing ST 20 1/2 (material) (depth)
4 (size) if telescope see back.
(5) screen NONE (length) (depth to top)
(size) (material)
(6) pump (HP) (yield gpm)
(type power)
(7) electric log NO (yes or no)
(organization running log)
(8) how well bottom plugged OPEN

description of formations encountered

from

to

Table with 3 columns: description of formations encountered, from, to. Rows include CLAY, SAND & GRAVEL, BLUE CLAY + SAND, SAND + CLAY.


INDEXED

DRILLERS REMARKS:

FEB 12 1973

If well telescopes please sketch and show depths.

GROUND LEVEL

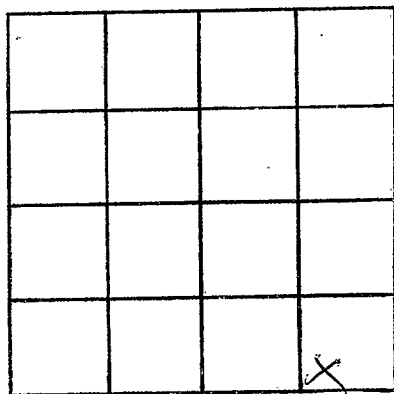

SECTION 6

Please indicate well location X.

ADDITIONAL INFORMATION

If more than one screen,
show locations of each on sketch.